

WATER WELL RECORD Form WWC-5


Original Record Correction Change in Well Use

Division of Water Resources App. No.

Well ID

1 LOCATION OF WATER WELL:
 County: **WABAUNSEE** Fraction $\frac{1}{4}$ SW $\frac{1}{4}$ NE $\frac{1}{4}$ SE $\frac{1}{4}$ Section Number **20** Township Number **T 14 S** Range Number **R 12 E**

2 WELL OWNER: Last Name: **SIR FARMS** First: **HARVEYVILLE** State: **KS** ZIP: **66431**
 Business: **SIR FARMS** Address: **16500 K 31 HWY** City: **HARVEYVILLE**
 Street or Rural Address where well is located (if unknown, distance and direction from nearest town or intersection): If at owner's address, check here:
3 SOUTH E 1/4 WEST OF ESKRIDGE

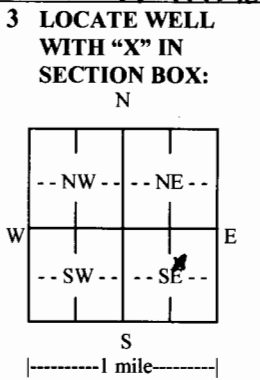

4 DEPTH OF COMPLETED WELL: **125** ft.
 Depth(s) Groundwater Encountered: 1) ft. 2) ft. 3) ft., or 4) Dry Well
 WELL'S STATIC WATER LEVEL: **107** ft.
 below land surface, measured on (mo-day-yr) **5/19/14**
 above land surface, measured on (mo-day-yr)
 Pump test data: Well water was ft. after hours pumping gpm
 Well water was ft. after hours pumping gpm
 Estimated Yield: **1.5** gpm
 Bore Hole Diameter: **8** in. to **125** ft. and in. to ft.

5 Latitude: (decimal degrees)
Longitude: (decimal degrees)
 Datum: WGS 84 NAD 83 NAD 27
 Source for Latitude/Longitude:
 GPS (unit make/model: (WAAS enabled? Yes No)
 Land Survey Topographic Map
 Online Mapper:
6 Elevation: ft. Ground Level TOC
 Source: Land Survey GPS Topographic Map
 Other

7 WELL WATER TO BE USED AS:

1. Domestic: <input checked="" type="checkbox"/> Household <input type="checkbox"/> Lawn & Garden <input type="checkbox"/> Livestock	2. <input type="checkbox"/> Irrigation	3. <input type="checkbox"/> Feedlot	4. <input type="checkbox"/> Industrial	5. <input type="checkbox"/> Public Water Supply: well ID	6. <input type="checkbox"/> Dewatering: how many wells?	7. <input type="checkbox"/> Aquifer Recharge: well ID	8. <input type="checkbox"/> Monitoring: well ID	9. Environmental Remediation: well ID <input type="checkbox"/> Air Sparge <input type="checkbox"/> Soil Vapor Extraction <input type="checkbox"/> Recovery <input type="checkbox"/> Injection	10. <input type="checkbox"/> Oil Field Water Supply: lease	11. Test Hole: well ID <input type="checkbox"/> Cased <input type="checkbox"/> Uncased <input type="checkbox"/> Geotechnical	12. Geothermal: how many bores? a) Closed Loop <input type="checkbox"/> Horizontal <input type="checkbox"/> Vertical b) Open Loop <input type="checkbox"/> Surface Discharge <input type="checkbox"/> Inj. of Water	13. <input type="checkbox"/> Other (specify):
---	--	-------------------------------------	--	--	---	---	---	---	--	---	---	---

Was a chemical/bacteriological sample submitted to KDHE? Yes No If yes, date sample was submitted:

8 TYPE OF CASING USED: Steel PVC Other CASING JOINTS: Glued Clamped Welded Threaded
 Casing diameter **5** in. to **105** ft., Diameter in. to ft., Diameter in. to ft.
 Casing height above land surface **1.8** in. Weight **2.8** lbs./ft. Wall thickness or gauge No. **2.65**

TYPE OF SCREEN OR PERFORATION MATERIAL:
 Steel Stainless Steel Fiberglass PVC Other (Specify)
 Brass Galvanized Steel Concrete tile None used (open hole)
 SCREEN OR PERFORATION OPENINGS ARE:
 Continuous Slot Mill Slot Gauze Wrapped Torch Cut Drilled Holes Other (Specify)
 Louvered Shutter Key Punched Wire Wrapped Saw Cut None (Open Hole)
 SCREEN-PERFORATED INTERVALS: From **105** ft. to **125** ft., From ft. to ft., From ft. to ft.
 GRAVEL PACK INTERVALS: From **25** ft. to **125** ft., From ft. to ft., From ft. to ft.

9 GROUT MATERIAL: Neat cement Cement grout Bentonite Other
 Grout Intervals: From **5** ft. to **25** ft., From ft. to ft., From ft. to ft.

Nearest source of possible contamination:
 Septic Tank Lateral Lines Pit Privy Livestock Pens Insecticide Storage
 Sewer Lines Cess Pool Sewage Lagoon Fuel Storage Abandoned Water Well
 Watertight Sewer Lines Seepage Pit Feedyard Fertilizer Storage Oil Well/Gas Well
 Other (Specify) **NONE PRESENT**
 Direction from well? Distance from well? **119 121 SHALE**
121 126 GRAYS

10 FROM	TO	LITHOLOGIC LOG	FROM	TO	LITHO. LOG (cont.) or PLUGGING INTERVALS
0	4	BROWN CLAY	35	50	GRAY SHALE
4	9	TAN SHALE	50	54	LIGHT GRAY SHALE (SOFT)
9	12	LIMESTONE	54	57	LIMESTONE (HARD)
12	15	YELLOW SHALE (SOFT)	57	68	GRAY SHALE
15	17	GRAY SHALE	68	69	LIMESTONE
17	20	YELLOW SHALE	69	74	LIGHT GRAY SHALE
20	24	LIMESTONE	Notes: 74 98 LIMESTONE 109 110 LIMESTONE 98 104 GRAY SHALE 110 116 Y. SHALE 104 109 YELLOW SHALE 116 119 LIMESTONE		
24	33	GRAY SHALE			
33	35	LIMESTONE			

11 CONTRACTOR'S OR LANDOWNER'S CERTIFICATION: This water well was constructed, reconstructed, or plugged under my jurisdiction and was completed on (mo-day-year) **5/19/14** and this record is true to the best of my knowledge and belief.
 Kansas Water Well Contractor's License No. **518** This Water Well Record was completed on (mo-day-year) **7/20/2014**
 under the business name of **BLUE VALLEY DRILLING INC. LLC**

INSTRUCTIONS: Send one copy to WATER WELL OWNER and retain one copy for your records. Submit fee of \$5.00 for each constructed well along with one (white) copy to Kansas Department of Health and Environment, Bureau of Water, Geology Section, 1000 SW Jackson St., Suite 420, Topeka, Kansas 66612-1367. Telephone (785) 296-3565.