


1 LOCATION OF WATER WELL: Fraction SE 1/4 SE 1/4 NW 1/4 Section Number 5 Township Number T 14 S Range Number R 12 EW
 County: WABAUNSEE

Distance and direction from nearest town or city street address of well if located within city?
1/8 mile north of Eskridge

2 WATER WELL OWNER: Monty Hase
 RR#, St. Address, Box # : Rt. 1 Board of Agriculture, Division of Water Resources
 City, State, ZIP Code : Eskridge, KS 66423 Application Number:

3 LOCATE WELL'S LOCATION WITH AN "X" IN SECTION BOX:

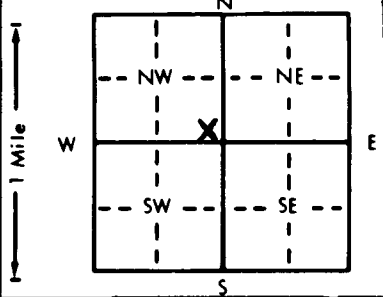

4 DEPTH OF COMPLETED WELL... 130' ft. ELEVATION:
 Depth(s) Groundwater Encountered 1. 110' ft. 2. ft. 3. ft.
 WELL'S STATIC WATER LEVEL .91' ft. below land surface measured on mo/day/yr 9-29-93
 Pump test data: Well water was ft. after hours pumping gpm
 Est. Yield .20 gpm: Well water was ft. after hours pumping gpm
 Bore Hole Diameter 8 3/4 in. to ft., and in. to ft.
 WELL WATER TO BE USED AS: 5 Public water supply 8 Air conditioning 11 Injection well
1 Domestic 3 Feedlot 6 Oil field water supply 9 Dewatering 12 Other (Specify below)
2 Irrigation 4 Industrial 7 Lawn and garden only 10 Monitoring well
 Was a chemical/bacteriological sample submitted to Department? Yes.....No. X.....; If yes, mo/day/yr sample was submitted
 Water Well Disinfected? Yes X No

5 TYPE OF BLANK CASING USED: 5 Wrought iron 8 Concrete tile CASING JOINTS: Glued X Clamped
 1 Steel 3 RMP (SR) 6 Asbestos-Cement 9 Other (specify below) Welded
 2 PVC 4 ABS 7 Fiberglass Threaded.....

Blank casing diameter 5" in. to 0-100 ft., Dia 5" in. to 120-130 ft., Dia in. to ft.
 Casing height above land surface 24" in., weight 2.82 lbs./ft. Wall thickness or gauge No. 258

TYPE OF SCREEN OR PERFORATION MATERIAL: 7 PVC 10 Asbestos-cement
 1 Steel 3 Stainless steel 5 Fiberglass 8 RMP (SR) 11 Other (specify)
 2 Brass 4 Galvanized steel 6 Concrete tile 9 ABS 12 None used (open hole)

SCREEN OR PERFORATION OPENINGS ARE: 5 Gauzed wrapped 8 Saw cut 11 None (open hole)
 1 Continuous slot 3 Mill slot 6 Wire wrapped 9 Drilled holes
 2 Louvered shutter 4 Key punched 7 Torch cut 10 Other (specify)

SCREEN-PERFORATED INTERVALS: From 100 ft. to 120 ft., From ft. to ft.
 From ft. to ft., From ft. to ft.
 GRAVEL PACK INTERVALS: From 24 ft. to 130 ft., From ft. to ft.
 From ft. to ft., From ft. to ft.

6 GROUT MATERIAL: 1 Neat cement 2 Cement grout 3 Bentonite 4 Other
 Grout Intervals: From 4 ft. to 24 ft., From ft. to ft., From ft. to ft.

What is the nearest source of possible contamination:
 1 Septic tank 4 Lateral lines 7 Pit privy 10 Livestock pens 14 Abandoned water well
 2 Sewer lines 5 Cess pool 8 Sewage lagoon 11 Fuel storage 15 Oil well/Gas well
 3 Watertight sewer lines 6 Seepage pit 9 Feedyard 12 Fertilizer storage 16 Other (specify below)
 13 Insecticide storage
 Direction from well? south How many feet? 340'

FROM	TO	LITHOLOGIC LOG	FROM	TO	PLUGGING INTERVALS
0	6	Clay-Brown	75	81	Shale-Grey
6	11	Limestone-Yellow	81	85	Limestone-Tan
11	16	Shale-Yellow	85	93	Shale-Tan
16	19	Limestone-Yellow	93	95	Limestone-Tan
19	25	Shale-Yellow	95	100	Shale-Grey
25	35	Shale-Grey	100	105	Limestone-Yellow-Loose
35	38	Shale-Red	105	106	Shale-Grey
38	45	Shale-Grey	106	107	Limestone-Yellow-Loose
45	48	Limestone-Tan	107	110	Shale-Grey
48	50	Shale-Grey	110	112	Limestone-Grey
50	57	Limestone-Grey	112	113	Shale-Yellow
57	58	Shale-Black	113	118	Limestone-Tan
58	62	Limestone-Tan	118	130	Shale-Grey
62	70	Shale-Grey			
70	75	Limestone-Tan			

7 CONTRACTOR'S OR LANDOWNER'S CERTIFICATION: This water well was (1) constructed, (2) reconstructed, or (3) plugged under my jurisdiction and was completed on (mo/day/year) 9-29-93 and this record is true to the best of my knowledge and belief. Kansas Water Well Contractor's License No. 182 This Water Well Record was completed on (mo/day/yr) 10-13-93 under the business name of STRADER DRILLING CO., INC. by (signature) Dale Hasken

OFFICE USE ONLY

T

R

EW

SEC

1/4

1/4

1/4