

USE TYPEWRITER OR BALL POINT PEN-PRESS FIRMLY, PRINT CLEARLY.

WATER WELL RECORD  
KSA 82a-1201-1215


T R EW sec 1/4 1/4 1/4 No.

Kansas State Dept. Of Health  
(Water Well Contractors)  
Forbes-Bldg. 740  
Topeka, Kansas 66620

Wabausca

1 Location of well:	County <del>Wabausca</del>	Township name Auburn	Fraction DDD SE 1/4 SE 1/4	Section number 10	Town number 14	Range number 13 E
---------------------	-------------------------------	-------------------------	----------------------------------	----------------------	-------------------	-------------------------

Distance and direction from nearest town or city: 3 N. 1 E	3 Owner of well: Bill McGlosson Address: RFD HARVEYVILLE, KS.
---	--

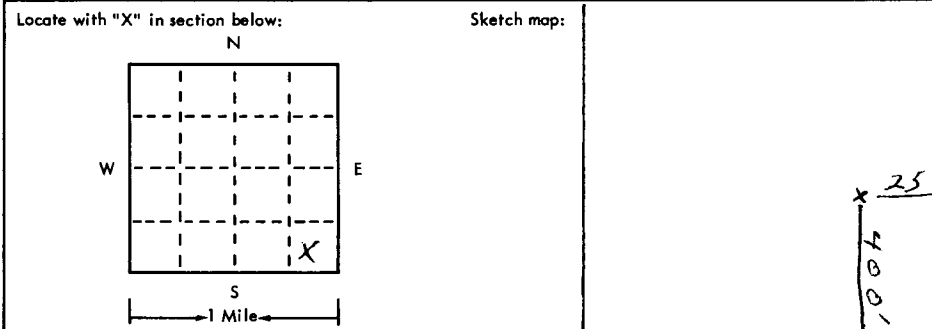

4 Well depth: 160 ft. Date of completion 8-4-75 Well diameter 5 in.
5 <input type="checkbox"/> Cible tool <input checked="" type="checkbox"/> Rotary <input type="checkbox"/> Driven <input type="checkbox"/> Dug <input type="checkbox"/> Hollow rod <input type="checkbox"/> Jetted <input type="checkbox"/> Bored <input type="checkbox"/> Reverse rotary
6 Use: <input checked="" type="checkbox"/> Domestic <input type="checkbox"/> Public supply <input type="checkbox"/> Industry <input type="checkbox"/> Irrigation <input type="checkbox"/> Air conditioning <input type="checkbox"/> Commercial <input type="checkbox"/> Test well
7 Casing: Material PVC Height: above/ <del>land</del> Threaded <input type="checkbox"/> Welded <input type="checkbox"/> Surface 24 in. Diam. Weight 237 lbs./ft. 5 in. to 160 ft. depth Drive shoe? <input type="checkbox"/> Yes <input checked="" type="checkbox"/> No

2	Type and color of material	From	To
	Top Soil	0	1
	Yellow Clay	1	9
	Grey Clay	9	13
	Yellow Shale	13	14
	Blue Shale	14	15
	Brown Limestone	15	16
	Grey Shale	16	21
	Yellow Shale	21	57
	Grey Shale	57	96
	Blk Shale	96	120
	Grey Limestone	120	124
	Grey Shale	124	144
	Grey Limestone	144	147
	Grey Shale	147	160

8 Screen: Manufacturer Pump Co Type PVC Dia. 5" Slot 1080 Length 20 Set between 118 ft. and 128 ft. Fittings: Gravel pack <input checked="" type="checkbox"/> Yes <input type="checkbox"/> No Size range of material
9 Static water level: NOT MEASURED ft. below land surface Date
10 Pumping level below land surfaces: AIR TEST ft. after hrs. pumping g.p.m. ft. after hrs. pumping g.p.m. Estimated maximum yield 1 g.p.m.
11 Water sample submitted: <input type="checkbox"/> Yes <input checked="" type="checkbox"/> No Date
12 Well head completion: CAPPED <input type="checkbox"/> Pitless adapter 24 <input checked="" type="checkbox"/> Inches above grade
13 Well grouted? <input checked="" type="checkbox"/> Yes <input type="checkbox"/> No <input checked="" type="checkbox"/> Neat cement <input type="checkbox"/> Bentonite Depth: From 2 ft. to 12 ft.
14 Nearest source of possible contamination: ft. 150 Direction SE Type S. Tank Well disinfected upon completion? <input checked="" type="checkbox"/> Yes <input type="checkbox"/> No
15 Pump: <input checked="" type="checkbox"/> Not installed Manufacturer's name Model number HP Volts Length of drop pipe ft. capacity g.m.p. Type: <input type="checkbox"/> Submersible <input type="checkbox"/> Turbine <input type="checkbox"/> Jet <input type="checkbox"/> Reciprocating <input type="checkbox"/> Centrifugal <input type="checkbox"/> Other

16 Remarks: elevation  
1260  
Topography:  
 Hill  
 Slope  
 Upland  
 Valley

17 Water well contractor's certification:  
This well was drilled under my jurisdiction and this report is true to the best of my knowledge and belief.  
S. Trader Drilling Co Inc 182  
Business name License No.  
Address RFD 1, Horton, KS  
Signed Dale Carter Date 8-11-75  
Authorized representative

13  
14  
15  
13E  
3A  
SESESE

Forward the white, blue and pink copies to the Kansas State Dept. Of Health.

Form WWC-5

BR = 1247

▽ =