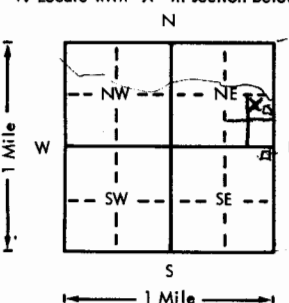


USE TYPEWRITER OR BALL POINT PEN—PRESS FIRMLY, PRINT CLEARLY.

WATER WELL RECORD
KSA 82a-1201-1215

Kansas Department of Health and Environment—Division of Environment
(Water well Contractors)
Topeka, Kansas 66620

1. Location of well:	County Osage	Fraction NE 1/4 SE 1/4 NE 1/4	Section number 8	Township number T 14 S R 14 E/W	Range number
2. Distance and direction from nearest town or city: Street address of well location if in city: 6N, 2W, 3/4 N Burlington.			3. Owner of well: Clancy, Jim R.R. or street: City, state, zip code: Topeka, KS.		
4. Locate with "X" in section below: Sketch map: 			6. Bore hole dia. 10 in. Completion date 4/26/76 Well depth 40 ft.		
5. Type and color of material			7. <input checked="" type="checkbox"/> Cable tool <input checked="" type="checkbox"/> Rotary <input type="checkbox"/> Driven <input type="checkbox"/> Dug <input type="checkbox"/> Hollow rod <input type="checkbox"/> Jetted <input type="checkbox"/> Bored <input type="checkbox"/> Reverse rotary		
			8. Use: <input checked="" type="checkbox"/> Domestic <input checked="" type="checkbox"/> Public supply <input type="checkbox"/> Industry <input type="checkbox"/> Irrigation <input type="checkbox"/> Air conditioning <input type="checkbox"/> Stock <input type="checkbox"/> Lawn <input type="checkbox"/> Oil field water <input type="checkbox"/> Other		
From			9. Casing: Material Steel Height: Above or below Threaded <input type="checkbox"/> Welded <input checked="" type="checkbox"/> Surface 84 in. RMP <input type="checkbox"/> PVC <input type="checkbox"/> Weight 13 lbs./ft. Dia. 4 1/2 in. to 40 ft. depth Wall Thickness: inches or Dia. <input type="checkbox"/> in. to <input type="checkbox"/> ft. depth gage No. 188		
			10. Screen: Manufacturer's name Steel Pipe & Supply Type Steel Dia. 6-5/8 Slot/gauze 1/2" hole Length 38.6 ft. Set between 20 ft. and 23 ft. 34 ft. and 40 ft. Gravel pack? Yes Size range of material 1/2"		
Line Rock and Yellow Clay			0	2	11. Static water level: <input type="checkbox"/> mo./day/yr. 5 ft. below land surface Date 11/3/75
Black Clay with Yellow Lime Rock			2	6	12. Pumping level below land surfaces: ____ ft. after ____ hrs. pumping ____ g.p.m. ____ ft. after ____ hrs. pumping ____ g.p.m. Estimated maximum yield 7 g.p.m.
Gravel and Sand			6	11	13. Water sample submitted: <input type="checkbox"/> Yes <input checked="" type="checkbox"/> No Date _____
White Lime			11	16	14. Well head completion: <input checked="" type="checkbox"/> Pitless adapter _____ Inches above grade
Lime Rock and Gray Shale			16	19	15. Well grouted? Yes With <input checked="" type="checkbox"/> Neat cement <input type="checkbox"/> Bentonite <input type="checkbox"/> Concrete Depth: From 2 ft. to 6 ft.
Lime Rock			19	22	16. Nearest source of possible contamination: ft. 20 Direction North Type Stream Well disinfected upon completion? <input checked="" type="checkbox"/> Yes <input type="checkbox"/> No
Gray Shale			22	29	17. Pump: <input type="checkbox"/> Not installed Manufacturer's name Pumpco Model number 102S36 HP 1/3 Volts 230 Length of drop pipe 35 ft. capacity 7 g.p.m. Type: <input checked="" type="checkbox"/> Submersible <input type="checkbox"/> Turbine <input type="checkbox"/> Jet <input type="checkbox"/> Reciprocating <input type="checkbox"/> Centrifugal <input type="checkbox"/> Other
White Shale			29	40	20. Water well contractor's certification: This well was drilled under my jurisdiction and this report is true to the best of my knowledge and belief. <i>Cummins Drilling Co 148</i> Business name _____ License No. _____ Address 10310 Topeka Signed <i>[Signature]</i> Date 4/26/76 Authorized representative
(Use a second sheet if needed)					
18. Elevation:		19. Remarks:			
Topography: <input type="checkbox"/> Hill <input type="checkbox"/> Slope <input type="checkbox"/> Upland <input checked="" type="checkbox"/> Valley					

Forward the white, blue and pink copies to the Department of Health and Environment

Form WWC-5

T 14 S R 14 E
Sec 8
NE SE NE
1/4 1/4 1/4