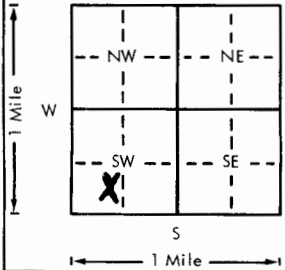
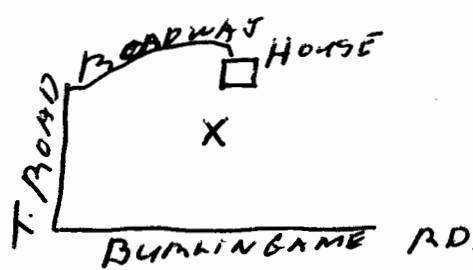


USE TYPEWRITER OR BALL
POINT PEN-PRESS FIRMLY,
PRINT CLEARLY.

WATER WELL RECORD
KSA 82a-1201-1215

Kansas Department of Health and
Environment-Division of Environment
(Water well Contractors)
Topeka, Kansas 66620

1. Location of well:		County OSAGE	Section number 12	Township number 14 E	Range number 14 S
2. Distance and direction from nearest town or city: Street address of well location if in city:		3. Owner of well: GABRIEL R. FAIMON R.R. or street: PO BOX 218 City, state, zip code: AUBURN KS. 66402			
4. Locate with "X" in section below:		Sketch map:			
					
5. Type and color of material		From	To	6. Well depth: 97 ft.	
CLAY YELLOW		0	19	7. <input checked="" type="checkbox"/> Cable tool <input type="checkbox"/> Rotary <input type="checkbox"/> Driven <input type="checkbox"/> Dig	
SANDY BLUE CLAY WET		19	34	<input type="checkbox"/> Hollow rod <input type="checkbox"/> Jetted <input type="checkbox"/> Bored <input type="checkbox"/> Reverse rotary	
LIME BLUE		34	38	8. Use: <input checked="" type="checkbox"/> Domestic <input type="checkbox"/> Public supply <input type="checkbox"/> Industry	
BROKEN BLUE LIME		38	70	<input type="checkbox"/> Irrigation <input type="checkbox"/> Air conditioning <input type="checkbox"/> Stock	
SHALE		70	97	<input type="checkbox"/> Lawn <input type="checkbox"/> Oil field water <input type="checkbox"/> Other	
7 7/8" HOLE TO 15'				9. Casing: Material RMP Height: Above or below	
22' 6" HOLE				Threading: 12 in. Dia. 5 in.	
				RMP X PVC X Weight 200 lbs./ft.	
				Dia. 5 in. to 97 ft. depth. Well Thickness: inches or	
				Dia. 5 in. to 97 ft. depth. gage No. 1021	
				10. Screen: Manufacturer's name PERFORATED RMP	
				Type 5 in. Dia. 5 in.	
				Slot/gauze 3/16 in. Length 78 in.	
				Set between 19 ft. and 97 ft.	
				Gravel pack? N/O Size range of material N/A	
				11. Static water level: 29 ft. below land surface Date 10-25-78	
				12. Pumping level below land surfaces:	
				BAILEY TEST	
				Estimated maximum yield 6 GPM	
				13. Water sample submitted: X No Date	
				14. Well head completion: X Pitless adapter 15 inches above grade	
				15. Well grouted? X With: X Neat cement <input type="checkbox"/> Bentonite <input type="checkbox"/> Concrete	
				Depth: From 15 ft. to 0 ft.	
				16. Nearest source of possible contamination: SEPTIC	
				Well disinfected upon completion? X Yes <input type="checkbox"/> No	
				17. Pump: X Not installed	
				Manufacturer's name JUNEMANN BROS	
				Model number 119 HP 1/4 Volts 230	
				Length of drop pipe 1/4 ft. capacity 1/4 g.p.m.	
				Type: <input type="checkbox"/> Submersible <input type="checkbox"/> Turbine	
				<input type="checkbox"/> Jet <input type="checkbox"/> Reciprocating	
				<input type="checkbox"/> Centrifugal <input type="checkbox"/> Other	
18. Elevation:		19. Remarks:			
Topography: X Hill <input type="checkbox"/> Slope <input type="checkbox"/> Upland <input type="checkbox"/> Valley		20. Water well contractor's certification: This well was drilled under my jurisdiction and this report is true to the best of my knowledge and belief. JUNEMANN BROS Business name CARBONDALE KS 66404 Address 10-25-78 Signed James B. Jones Date 10-25-78 Authorized representative			

Forward the white, blue and pink copies to the Department of Health and Environment

Form WWC-5