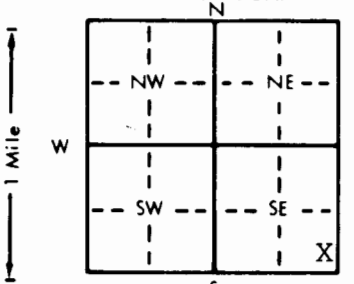


1 LOCATION OF WATER WELL: Fraction SE 1/4 SE 1/4 SE 1/4 Section Number 26 Township Number T 14 S Range Number R 15 EW
 County: OSAGE

Distance and direction from nearest town or city street address of well if located within city?

1 mile south, 1 1/8 west of Carbondale

2 WATER WELL OWNER: Calvin McAlexander
 RR#, St. Address, Box #: 1416 West 149th Board of Agriculture, Division of Water Resources
 City, State, ZIP Code: Scranton, KS 66537 Application Number:

3 LOCATE WELL'S LOCATION WITH AN "X" IN SECTION BOX:  4 DEPTH OF COMPLETED WELL: 200' ft. ELEVATION: _____ ft.
 Depth(s) Groundwater Encountered 1. _____ ft. 2. _____ ft. 3. _____ ft.
 WELL'S STATIC WATER LEVEL: 98' ft. below land surface measured on mo/day/yr 7/31/97
 Pump test data: Well water was _____ ft. after _____ hours pumping _____ gpm
 Est. Yield 15 GPH Well water was _____ ft. after _____ hours pumping _____ gpm
 Bore Hole Diameter: 8 3/4 in. to _____ ft., and _____ in. to _____ ft.
 WELL WATER TO BE USED AS: 5 Public water supply 8 Air conditioning 11 Injection well
 1 Domestic 3 Feedlot 6 Oil field water supply 9 Dewatering 12 Other (Specify below)
 2 Irrigation 4 Industrial 7 Lawn and garden only 10 Monitoring well
 Was a chemical/bacteriological sample submitted to Department? Yes _____ No X; If yes, mo/day/yr sample was submitted _____
 Water Well Disinfected? Yes X No _____

5 TYPE OF BLANK CASING USED: 5 Wrought iron 8 Concrete tile CASING JOINTS: Glued X Clamped _____
 1 Steel 3 RMP (SR) 6 Asbestos-Cement 9 Other (specify below) Welded _____
 2 PVC 4 ABS 7 Fiberglass Threaded _____
 Blank casing diameter: 5" in. to 0-100 ft., Dia 5" in. to 120-140 ft., Dia _____ in. to 160-180 ft.
 Casing height above land surface: 24" in., weight 2.82 lbs./ft. Wall thickness or gauge No. .258
 TYPE OF SCREEN OR PERFORATION MATERIAL: 7 PVC 10 Asbestos-cement
 1 Steel 3 Stainless steel 5 Fiberglass 8 RMP (SR) 11 Other (specify) _____
 2 Brass 4 Galvanized steel 6 Concrete tile 9 ABS 12 None used (open hole)
 SCREEN OR PERFORATION OPENINGS ARE: 5 Gauzed wrapped 8 Saw cut 11 None (open hole)
 1 Continuous slot 3 Mill slot 6 Wire wrapped 9 Drilled holes
 2 Louvered shutter 4 Key punched 7 Torch cut 10 Other (specify) _____
 SCREEN-PERFORATED INTERVALS: From 100 ft. to 120 ft., From 140 ft. to 160 ft.
 From 180 ft. to 200 ft., From _____ ft. to _____ ft.
 GRAVEL PACK INTERVALS: From 24 ft. to 200 ft., From _____ ft. to _____ ft.
 From _____ ft. to _____ ft., From _____ ft. to _____ ft.

6 GROUT MATERIAL: 1 Neat cement 2 Cement grout 3 Bentonite 4 Other _____
 Grout Intervals: From 4 ft. to 24 ft., From _____ ft. to _____ ft., From _____ ft. to _____ ft.
 What is the nearest source of possible contamination:
 1 Septic tank 4 Lateral lines 7 Pit privy 10 Livestock pens 14 Abandoned water well
 2 Sewer lines 5 Cess pool 8 Sewage lagoon 11 Fuel storage 15 Oil well/Gas well
 3 Watertight sewer lines 6 Seepage pit 9 Feedyard 12 Fertilizer storage 16 Other (specify below)
 13 Insecticide storage
 Direction from well? SE How many feet? 500'

FROM	TO	LITHOLOGIC LOG	FROM	TO	PLUGGING INTERVALS
0	1	Top Soil	134	138	Sandstone-Silty-Gr
1	10	Clay-Brown	138	144	Shale-Grey
10	15	Clay-Br-Cherty LS	144	148	Sandstone-Gr-Silty
15	18	Clay-Brown	148	153	Shale-Grey
18	23	Shale-Yellow	153	158	Sandstone-Grey-Silty
23	28	Limestone-Tan	158	163	Shale-Grey
28	30	Limestone-Grey	163	172	Limestone-Grey
30	45	Shale-Grey	172	174	Shale-Grey
45	47	Shale-Black	174	184	Limestone-Grey
47	91	Shale-Grey	184	188	Shale-Grey
91	93	Shale-Black	188	191	Limestone-Grey
93	95	Limestone-Grey	191	200	Shale-Grey
95	98	Shale-Grey			
98	119	Limestone-Grey			
119	134	Shale-Grey			

7 CONTRACTOR'S OR LANDOWNER'S CERTIFICATION: This water well was (1) constructed, (2) reconstructed, or (3) plugged under my jurisdiction and was completed on (mo/day/year) 7/31/97 and this record is true to the best of my knowledge and belief. Kansas Water Well Contractor's License No. 182 This Water Well Record was completed on (mo/day/yr) 8-29-97 under the business name of STRADER DRILLING CO., INC. by (signature) Dale Strader