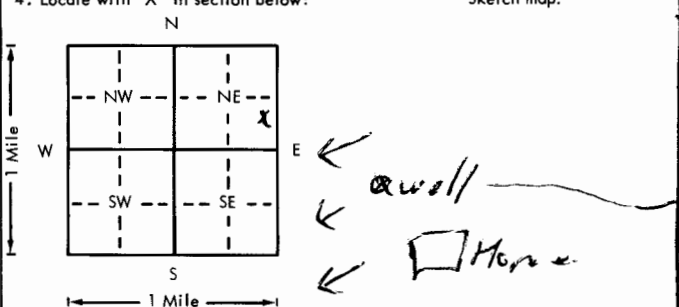


USE TYPEWRITER OR BALL POINT PEN-PRESS FIRMLY, PRINT CLEARLY.

WATER WELL RECORD  
KSA 82a-1201-1215

Kansas Department of Health and Environment-Division of Environment  
(Water well Contractors)  
Topeka, Kansas 66620

1. Location of well: <u>Osage</u>		County: <u>Osage</u>		Fraction: <u>1/4 SE 1/4 NE 1/4</u>		Section number: <u>1</u>		Township number: <u>T 14 S</u>		Range number: <u>R 15 E</u>		E/W: <u>E/W</u>	
2. Distance and direction from nearest town or city: <u>2 1/2 mi North of C-Dale</u>				3. Owner of well: <u>Jim Bump</u>		R.R. or street: <u>2835 Pennsylvania</u>		City, state, zip code: <u>Topeka, Mo.</u>		6. Bore hole dia. <u>6 7/8</u> in. Completion date <u>6-8-78</u> Well depth <u>114</u> ft.			
4. Locate with "X" in section below: 				Sketch map: <u>254 survey</u>		7. <input checked="" type="checkbox"/> Cable tool <input type="checkbox"/> Rotary <input type="checkbox"/> Driven <input type="checkbox"/> Dug <input type="checkbox"/> Hollow rod <input type="checkbox"/> Jetted <input type="checkbox"/> Bored <input type="checkbox"/> Reverse rotary		8. Use: <input checked="" type="checkbox"/> Domestic <input type="checkbox"/> Public supply <input type="checkbox"/> Industry <input type="checkbox"/> Irrigation <input type="checkbox"/> Air conditioning <input type="checkbox"/> Stock <input type="checkbox"/> Lawn <input type="checkbox"/> Oil field water <input type="checkbox"/> Other		9. Casing: Material <u>PITS</u> Height: Above or below Threaded <input type="checkbox"/> Welded <input type="checkbox"/> Surface <u>24</u> in. RMP <u>2</u> PVC <input type="checkbox"/> Weight <input type="checkbox"/> lbs./ft. Dia. <u>5</u> in. to <u>114</u> ft. depth Wall Thickness: inches or Dia. <input type="checkbox"/> in. to <input type="checkbox"/> ft. depth gage No. <u>200</u>			
5. Type and color of material				From		To		10. Screen: Manufacturer's name <u>Sunflower</u>		Type <u>RMP</u> Dia. <u>5 1/2</u> Slot/gauze <u>3/16</u> Length <u>89'</u> Set between <u>23</u> ft. and <u>114</u> ft. ft. and <input type="checkbox"/> ft. Gravel pack? <u>no</u> Size range of material <input type="checkbox"/>			
<u>Top Soil</u>				<u>0</u>		<u>2</u>		11. Static water level: <u>24</u> ft. below land surface Date <u>10-8-78</u>		mo./day/yr. <u>10-8-78</u>			
<u>lime yellow</u>				<u>2</u>		<u>5</u>		12. Pumping level below land surfaces: <input type="checkbox"/> ft. after <input type="checkbox"/> hrs. pumping <input type="checkbox"/> g.p.m. <input type="checkbox"/> ft. after <input type="checkbox"/> hrs. pumping <input type="checkbox"/> g.p.m.		Estimated maximum yield <u>12 g.p.m.</u>			
<u>Dr lime yellow</u>				<u>5</u>		<u>9</u>		13. Water sample submitted: <input type="checkbox"/> Yes <input checked="" type="checkbox"/> No Date <input type="checkbox"/>		mo./day/yr. <input type="checkbox"/>			
<u>Clay yellow</u>				<u>9</u>		<u>15</u>		14. Well head completion: <input type="checkbox"/> Pitless adapter <u>24</u> Inches above grade		15. Well grouted? <u>yes</u> With: <input checked="" type="checkbox"/> Neat cement <input type="checkbox"/> Bentonite <input type="checkbox"/> Concrete Depth: From <u>0</u> ft. to <u>20</u> ft.			
<u>lime</u>				<u>15</u>		<u>25</u>		16. Nearest source of possible contamination: ft. <u>100+</u> Direction <u>South</u> Type <u>Septic</u>		Well disinfected upon completion? <input checked="" type="checkbox"/> Yes <input type="checkbox"/> No			
<u>Shale grey</u>				<u>25</u>		<u>62</u>		17. Pump: <input checked="" type="checkbox"/> Not installed		Manufacturer's name <input type="checkbox"/> Model number <input type="checkbox"/> HP <input type="checkbox"/> Volts <input type="checkbox"/> Length of drop pipe <input type="checkbox"/> ft. capacity <input type="checkbox"/> g.p.m. Type: <input type="checkbox"/> Submersible <input type="checkbox"/> Turbine <input type="checkbox"/> Jet <input type="checkbox"/> Reciprocating <input type="checkbox"/> Centrifugal <input type="checkbox"/> Other			
<u>lime hard</u>				<u>62</u>		<u>83</u>		20. Water well contractor's certification: This well was drilled under my jurisdiction and this report is true to the best of my knowledge and belief.		Signature: <u>Robison Drilling 316</u> License No. <input type="checkbox"/> Business name <u>Perry Kous</u> Address <u>John Perry</u> Date <u>6-8-78</u> Signed <u>John Perry</u> Authorized representative			
<u>Shale grey sticky</u>				<u>83</u>		<u>87</u>		18. Elevation:		19. Remarks: <u>owner to install cement slab</u>			
<u>lime</u>				<u>87</u>		<u>92</u>		(Use a second sheet if needed)					
<u>Shale grey</u>				<u>92</u>		<u>96</u>							
<u>lime</u>				<u>96</u>		<u>114</u>							
Topography: <input type="checkbox"/> Hill <input type="checkbox"/> Slope <input checked="" type="checkbox"/> Upland <input type="checkbox"/> Valley													

T 14 S R 15 E E/W