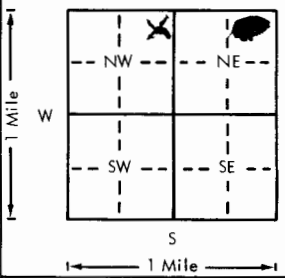
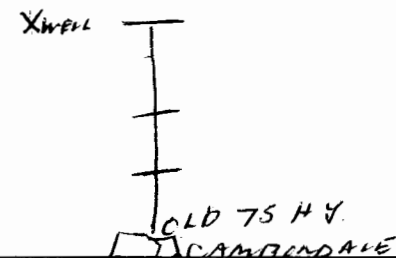


USE TYPEWRITER OR BALL POINT PEN-PRESS FIRMLY, PRINT CLEARLY.

WATER WELL RECORD
KSA 82a-1201-1215

Kansas Department of Health and Environment-Division of Environment
(Water well Contractors)
Topeka, Kansas 66620

1. Location of well:	County OSAGE	Xraction NE 1/4 NE 1/4 NW 1/4	Section number 1	Township number T 14 S	Range number S R 15 E
2. Distance and direction from nearest town or city: Street address of well location if in city:			3. Owner of well: R.R. or street: City, state, zip code:		
2. Distance and direction from nearest town or city: 3 MI NORTH CAMBONDAIE Street address of well location if in city: CAMBONDAIE			3. Owner of well: RODMICHT D. ANDERSON R.R. or street: RFD. 1 CAMBONDAIE 66414 City, state, zip code:		
X Locate with "X" in section below: 		Sketch map: 		6. Bore hole dia. 9 in. Completion date 6-16-79 Well depth 70 ft.	
5. Type and color of material		From	To	7. <input checked="" type="checkbox"/> Cable tool <input type="checkbox"/> Rotary <input type="checkbox"/> Driven <input type="checkbox"/> Dug <input type="checkbox"/> Hollow rod <input type="checkbox"/> Jetted <input type="checkbox"/> Bored <input type="checkbox"/> Reverse rotary	
Soil		0	5	8. Use: <input checked="" type="checkbox"/> Domestic <input type="checkbox"/> Public supply <input type="checkbox"/> Industry <input type="checkbox"/> Irrigation <input type="checkbox"/> Air conditioning <input type="checkbox"/> Stock <input type="checkbox"/> Lawn <input type="checkbox"/> Oil field water <input type="checkbox"/> Other	
LIME BEDDED		5	15	9. Casing: Material _____ Height: Above or below Threaded _____ Welded _____ Surface 12" in. RMP <input checked="" type="checkbox"/> PVC _____ Weight _____ lbs./ft.	
SHALE		15	16	Dia. 5 in. to 70 ft. depth Wall Thickness: inches or Dia. _____ in. to _____ ft. depth Gage No. 02"	
LIME		16	20	10. Screen: Manufacturer's name SLECTED RMP.	
SHALE		20	45	Type RMP Dia. 5 Slot/gauze 4" Length 35' <input checked="" type="checkbox"/> Set between 35 ft. and 70 ft. _____ ft. and _____ ft.	
SANDY SHALE (WATER)		45	48	Gravel pack? NO Size range of material _____	
LIME		48	49	11. Static water level: _____ mo./day/yr. 23' ft. below land surface Date 6-16-79	
SHALE SANDY		49	70	12. Pumping level below land surfaces: _____ ft. after _____ hrs. pumping _____ g.p.m. _____ ft. after _____ hrs. pumping _____ g.p.m. Estimated maximum yield 8 GPH. g.p.m.	
LIME		70		13. Water sample submitted: _____ mo./day/yr. <input checked="" type="checkbox"/> Yes <input type="checkbox"/> No Date _____	
				14. Well head completion: <input checked="" type="checkbox"/> Pitless adapter 12" inches above grade	
				15. Well grouted? YES With: <input checked="" type="checkbox"/> Neat cement <input type="checkbox"/> Bentonite <input type="checkbox"/> Concrete Depth: From 0 ft. to 20 ft.	
				16. Nearest source of possible contamination: ft. 150 Direction WEST Type SEPTIC Well disinfected upon completion? <input checked="" type="checkbox"/> Yes <input type="checkbox"/> No	
				17. Pump: _____ Not installed Manufacturer's name JANUZZI Model number 354A HP 1/2 Volt 230 Length of drop pipe 68 ft. capacity 6 g.p.m. Type: <input checked="" type="checkbox"/> Submersible <input type="checkbox"/> Turbine <input type="checkbox"/> Jet <input type="checkbox"/> Reciprocating <input type="checkbox"/> Centrifugal <input type="checkbox"/> Other	
				20. Water well contractor's certification: This well was drilled under my jurisdiction and this report is true to the best of my knowledge and belief. JANUZZI 119 Business name License No. Address CAMBONDAIE MS. 66414 Signed James Januzzi Date 7-8-79 Authorized representative	
18. Elevation:	19. Remarks:				
Topography: <input type="checkbox"/> Hill <input checked="" type="checkbox"/> Slope <input type="checkbox"/> Upland <input type="checkbox"/> Valley					

T 14 S
 R 15 E
 NW
 1/4
 NE
 NW
 1/4
 1/4
 NE
 NW
 1/4