


1 LOCATION OF WATER WELL: Fraction NW 1/4 NE 1/4 SW 1/4 Section Number 6 Township Number T 14 S Range Number R 15 E  
 County: Osage

Distance and direction from nearest town or city street address of well if located within city?  
5 1/2 Miles West of Carbondale. 2 1/8 miles North

2 WATER WELL OWNER: Aaron Howey  
 RR#, St. Address, Box #: Rt 2 Box 39 Board of Agriculture, Division of Water Resources  
 City, State, ZIP Code: Carbondale, KS Application Number:

3 LOCATE WELL'S LOCATION WITH AN "X" IN SECTION BOX:

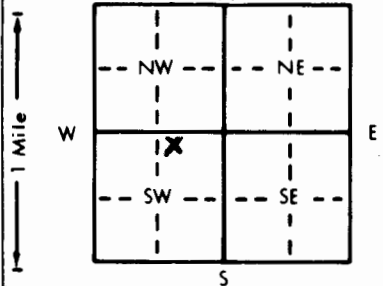

4 DEPTH OF COMPLETED WELL: 98 ft. ELEVATION:  
 Depth(s) Groundwater Encountered 1. 24ft ft. 2. ft. 3. ft.  
 WELL'S STATIC WATER LEVEL 24ft ft. below land surface measured on mo/day/yr 9/24/91  
 Pump test data: Well water was ft. after hours pumping gpm  
 Est. Yield 3/4 gpm: Well water was ft. after hours pumping gpm  
 Bore Hole Diameter: 9 in. to 98 ft., and in. to ft.  
 WELL WATER TO BE USED AS:  
 1 Domestic 3 Feedlot 6 Oil field water supply 9 Dewatering 12 Other (Specify below)  
 2 Irrigation 4 Industrial 7 Lawn and garden only 10 Monitoring well  
 Was a chemical/bacteriological sample submitted to Department? Yes No  If yes, mo/day/yr sample was submitted  
 Water Well Disinfected?  Yes No

5 TYPE OF BLANK CASING USED:  
 1 Steel 3 RMP (SR) 5 Wrought iron 8 Concrete tile CASING JOINTS: Glued  Clamped  
 2 PVC 4 ABS 6 Asbestos-Cement 9 Other (specify below) Welded  
 7 Fiberglass Threaded  
 Blank casing diameter: 5.58 in. to 24ft ft., Dia. in. to ft., Dia. in. to ft.  
 Casing height above land surface: 18 inches in., weight lbs./ft. Wall thickness or gauge No. SDR-26  
 TYPE OF SCREEN OR PERFORATION MATERIAL:  
 7 PVC 10 Asbestos-cement  
 1 Steel 3 Stainless steel 5 Fiberglass 8 RMP (SR) 11 Other (specify)  
 2 Brass 4 Galvanized steel 6 Concrete tile 9 ABS 12 None used (open hole)  
 SCREEN OR PERFORATION OPENINGS ARE:  
 1 Continuous slot  3 Mill slot 5 Gauzed wrapped  8 Saw cut 11 None (open hole)  
 2 Louvered shutter 4 Key punched 6 Wire wrapped 9 Drilled holes  
 7 Torch cut 10 Other (specify)  
 SCREEN-PERFORATED INTERVALS: From 98 ft. to 24 ft., From ft. to ft.  
 From ft. to ft., From ft. to ft.  
 GRAVEL PACK INTERVALS: From 98 ft. to 24 ft., From ft. to ft.  
 From ft. to ft., From ft. to ft.

6 GROUT MATERIAL: 1 Neat cement  2 Cement grout 3 Bentonite 4 Other  
 Grout intervals: From 24 ft. to 0 ft., From ft. to ft., From ft. to ft.  
 What is the nearest source of possible contamination:  
 1 Septic tank  4 Lateral lines 7 Pit privy 11 Fuel storage 14 Abandoned water well  
 2 Sewer lines 5 Cess pool 8 Sewage lagoon 12 Fertilizer storage 15 Oil well/Gas well  
 3 Watertight sewer lines 6 Seepage pit 9 Feedyard 13 Insecticide storage 16 Other (specify below)  
 Direction from well? East How many feet? 210ft

FROM	TO	LITHOLOGIC LOG	FROM	TO	PLUGGING INTERVALS
0	8	Black Top Soil			
8	10	Dk. Gray Limestone			
10	19	Blue-gray to Blue silty shale			
19	21	Dk. Blue silty calcareous shale			
21	24	lt. Gray Sandstone			
24	25	Gray Limestone			
25	28	Blue-gray shale			
28	29	Coal seam			
29	31	Dk. Blue shale			
31	32	Coal seam			
32	34	Gray shale			
34	54	Dk. Gray silty sandstone			
54	65	Dk. Gray sandstone, w/ sparse lens			
65	98	Dk. Gray to Black shale			

7 CONTRACTOR'S OR LANDOWNER'S CERTIFICATION: This water well was (1)  constructed (2) reconstructed, or (3) plugged under my jurisdiction and was completed on (mo/day/year) 9/24/91 and this record is true to the best of my knowledge and belief. Kansas  
 Water Well Contractor's License No. 539 This Water Well Record was completed on (mo/day/yr) 10/24/91  
 under the business name of J.B. Environmental Drilling by (signature) James Bueker

INSTRUCTIONS: Use typewriter or ball point pen. PLEASE PRESS FIRMLY and PRINT clearly. Please fill in blanks, underline or circle the correct answers. Send top three copies to Kansas Department of Health and Environment, Bureau of Water, Topeka, Kansas 66620-7320. Telephone: 913-296-5545. Send one to WATER WELL OWNER and retain one for your records.