


1 LOCATION OF WATER WELL:	Fraction	Section Number	Township Number	Range Number
County: OSAGE	SE 1/4 NW 1/4 NE 1/4	8	T 14 S	R 15 EW

Distance and direction from nearest town or city street address of well if located within city?
 1 3/4 north, 2 1/4 west of Carbondale

2 WATER WELL OWNER: Wittmer Realty
 RR#, St. Address, Box # : 1136 SW Wanamaker Board of Agriculture, Division of Water Resources
 City, State, ZIP Code : Topeka, KS 66604 Application Number:

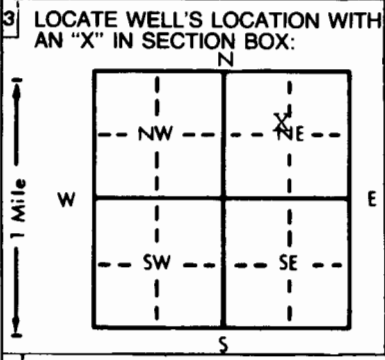

4 DEPTH OF COMPLETED WELL: 120 ft. ELEVATION:
 Depth(s) Groundwater Encountered 1. 16-36 ft. 2. ft. 3. ft.
 WELL'S STATIC WATER LEVEL .16' ft. below land surface measured on mo/day/yr 11-18-91
 Pump test data: Well water was ft. after hours pumping gpm
 Est. Yield .10 gpm Well water was ft. after hours pumping gpm
 Bore Hole Diameter .8 3/4 in. to ft., and in. to ft.
 WELL WATER TO BE USED AS: 5 Public water supply 8 Air conditioning 11 Injection well
 1 Domestic 3 Feedlot 6 Oil field water supply 9 Dewatering 12 Other (Specify below)
 2 Irrigation 4 Industrial 7 Lawn and garden only 10 Monitoring well
 Was a chemical/bacteriological sample submitted to Department? Yes.....No.....X.....; If yes, mo/day/yr sample was submitted
 Water Well Disinfected? Yes X No

5 TYPE OF BLANK CASING USED:
 1 Steel 3 RMP (SR) 5 Wrought iron 8 Concrete tile CASING JOINTS: Glued X Clamped
 2 PVC 4 ABS 6 Asbestos-Cement 9 Other (specify below) Welded
 7 Fiberglass Threaded
 Blank casing diameter .5" in. to 0-16 ft., Dia .5" in. to 36-120 ft., Dia in. to ft.
 Casing height above land surface .24" in., weight .2.82 lbs./ft. Wall thickness or gauge No. .258
 TYPE OF SCREEN OR PERFORATION MATERIAL:
 1 Steel 3 Stainless steel 5 Fiberglass 7 PVC 10 Asbestos-cement
 2 Brass 4 Galvanized steel 6 Concrete tile 8 RMP (SR) 11 Other (specify)
 12 None used (open hole)
 SCREEN OR PERFORATION OPENINGS ARE:
 1 Continuous slot 3 Mill slot 5 Gauzed wrapped 8 Saw cut 11 None (open hole)
 2 Louvered shutter 4 Key punched 6 Wire wrapped 9 Drilled holes
 7 Torch cut 10 Other (specify)
 SCREEN-PERFORATED INTERVALS: From .16 ft. to .36 ft., From ft. to ft.
 From ft. to ft., From ft. to ft.
 GRAVEL PACK INTERVALS: From .14 ft. to .120 ft., From ft. to ft.
 From ft. to ft., From ft. to ft.

6 GROUT MATERIAL: 1 Neat cement 2 Cement grout 3 Bentonite 4 Other
 Grout Intervals: From .0 ft. to .14 ft., From ft. to ft., From ft. to ft.
 What is the nearest source of possible contamination:
 1 Septic tank 4 Lateral lines 7 Pit privy 10 Livestock pens 14 Abandoned water well
 2 Sewer lines 5 Cess pool 8 Sewage lagoon 11 Fuel storage 15 Oil well/Gas well
 3 Watertight sewer lines 6 Seepage pit 9 Feedyard 12 Fertilizer storage 16 Other (specify below)
 13 Insecticide storage
 Direction from well? east How many feet? 150'

FROM	TO	LITHOLOGIC LOG	FROM	TO	PLUGGING INTERVALS
0	16	Clay-Brown			
16	18	Shale-Yellow			
18	93	Shale-Grey			
93	96	Limestone-Grey			
96	97	Shale-Grey			
97	101	Limestone-Grey			
101	102	Shale-Grey			
102	106	Limestone-Grey			
106	120	Shale-Grey			

NOTE: 11-26-91 Received permission from Mike Cochran to shallow grout 0-14'

7 CONTRACTOR'S OR LANDOWNER'S CERTIFICATION: This water well was (1) constructed, (2) reconstructed, or (3) plugged under my jurisdiction and was completed on (mo/day/year) 11-18-91 and this record is true to the best of my knowledge and belief. Kansas Water Well Contractor's License No. 182 This Water Well Record was completed on (mo/day/yr) 11-18-91 under the business name of STRADER DRILLING CO., INC. by (signature) Dale Cochran

INSTRUCTIONS: Use typewriter or ball point pen. PLEASE PRESS FIRMLY and PRINT clearly. Please fill in blanks, underline or circle the correct answers. Send top three copies to Kansas Department of Health and Environment, Bureau of Water, Topeka, Kansas 66620-0001. Telephone: 913-296-5545. Send one to WATER WELL OWNER and retain one for your records.