


1 LOCATION OF WATER WELL: County: OSAGE Fraction: SE NW 1/4 SW 1/4 NW 1/4 Section Number: 10 Township Number: T 14 S Range Number: R 15 E/W

Distance and direction from nearest town or city street address of well if located within city? IN 2 1/2 WEST CAMBONDALE

2 WATER WELL OWNER: TILLIE OBERLE
RR#, St. Address, Box #: RR 2 Board of Agriculture, Division of Water Resources
City, State, ZIP Code: CAMBONDALE KS. 66414 Application Number:

3 LOCATE WELL'S LOCATION WITH AN "X" IN SECTION BOX:

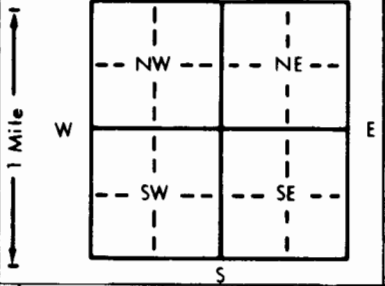

4 DEPTH OF COMPLETED WELL: 180? ft. ELEVATION: _____

Depth(s) Groundwater Encountered: 1. _____ ft. 2. _____ ft. 3. _____ ft.
WELL'S STATIC WATER LEVEL: 52 ft. below land surface measured on mo/day/yr 4-10-92
Pump test data: Well water was _____ ft. after _____ hours pumping _____ gpm
Est. Yield _____ gpm: Well water was _____ ft. after _____ hours pumping _____ gpm
Bore Hole Diameter _____ in. to _____ ft., and _____ in. to _____ ft.
WELL WATER TO BE USED AS:
 1 Domestic 3 Feedlot 6 Oil field water supply 9 Dewatering 12 Other (Specify below)
 2 Irrigation 4 Industrial 7 Lawn and garden only 10 Monitoring well
Was a chemical/bacteriological sample submitted to Department? Yes _____ No ; If yes, mo/day/yr sample was submitted _____
Water Well Disinfected? Yes _____ No

5 TYPE OF BLANK CASING USED:
 1 Steel 3 RMP (SR) 5 Wrought iron 8 Concrete tile CASING JOINTS: Glued _____ Clamped _____
 2 PVC 4 ABS 6 Asbestos-Cement 9 Other (specify below) Welded _____
 7 Fiberglass Threaded

Blank casing diameter: 5" in. UNKNOWN Dia. 5" in. to _____ ft., Dia. _____ in. to _____ ft.
Casing height above land surface: 24" in., weight _____ lbs./ft. Wall thickness or gauge No. _____

TYPE OF SCREEN OR PERFORATION MATERIAL:
 1 Steel 3 Stainless steel 5 Fiberglass 8 RMP (SR) 11 Other (specify) _____
 2 Brass 4 Galvanized steel 6 Concrete tile 9 ABS 12 None used (open hole)

SCREEN OR PERFORATION OPENINGS ARE:
1 Continuous slot 3 Mill slot 5 Gauzed wrapped 8 Saw cut 11 None (open hole)
2 Louvered shutter 4 Key punched 6 Wire wrapped 9 Drilled holes
7 Torch cut 10 Other (specify) N/A

SCREEN-PERFORATED INTERVALS: From _____ ft. to _____ ft., From _____ ft. to _____ ft.
GRAVEL PACK INTERVALS: From _____ ft. to _____ ft., From _____ ft. to _____ ft.

6 GROUT MATERIAL: 1 Neat cement 2 Cement grout 3 Bentonite 4 Other _____
Grout Intervals: From UNKNOWN ft., From _____ ft. to _____ ft., From _____ ft. to _____ ft.

What is the nearest source of possible contamination:
1 Septic tank 4 Lateral lines 7 Pit privy 10 Livestock pens 14 Abandoned water well
2 Sewer lines 5 Cess pool 8 Sewage lagoon 11 Fuel storage 15 Oil well/Gas well
3 Watertight sewer lines 6 Seepage pit 9 Feedyard 12 Fertilizer storage 16 Other (specify below)
13 Insecticide storage _____
Direction from well? SW How many feet? 200' SW

FROM	TO	LITHOLOGIC LOG	FROM	TO	PLUGGING INTERVALS
		<u>WELL WAS IN A PIT WELL DRILLED 1937?</u>			
		<u>CASING EXTENDED TO 24" ABOVE GRADE</u>			
		<u>WITH 5" PVC SD424</u>			
		<u>BETWEEN TWO CASINGS WITH TIGHT TITE 1" OF</u>			
		<u>CEMENT 18" DIAMETER SURROUNDING JOINT</u>			

7 CONTRACTOR'S OR LANDOWNER'S CERTIFICATION: This water well was (1) constructed, reconstructed or (3) plugged under my jurisdiction and was completed on (mo/day/year) 4-15-92 and this record is true to the best of my knowledge and belief. Kansas Water Well Contractor's License No. 119 This Water Well Record was completed on (mo/day/yr) 4-17-92 under the business name of JUNGMAN BROS. DRILLING CO. by (signature) John B. Jungman