


1 LOCATION OF WATER WELL:	Fraction	Section Number	Township Number	Range Number
County: OSAGE	NW 1/4 NE 1/4 NE 1/4	15	T 14 S	R 15 E/W

Distance and direction from nearest town or city street address of well if located within city?
1 north, 2 west of Carbondale

2 WATER WELL OWNER: Monty Worthington
 RR#, St. Address, Box #: 925 SE Green Rd.
 City, State, ZIP Code: Tecumseh, KS 66542

Board of Agriculture, Division of Water Resources
 Application Number:

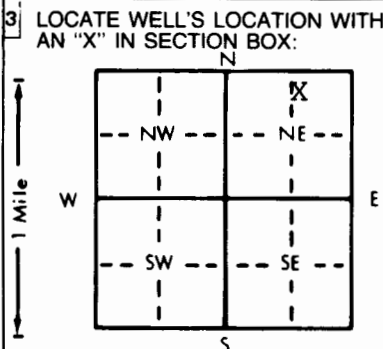

4 DEPTH OF COMPLETED WELL: 100' ft. ELEVATION:

Depth(s) Groundwater Encountered 1. 40' ft. 2. _____ ft. 3. _____ ft.

WELL'S STATIC WATER LEVEL _____ ft. below land surface measured on mo/day/yr

Pump test data: Well water was _____ ft. after _____ hours pumping _____ gpm

Est. Yield 1 gpm: Well water was _____ ft. after _____ hours pumping _____ gpm

Bore Hole Diameter: 8 3/4 in. to _____ ft., and _____ in. to _____ ft.

WELL WATER TO BE USED AS:

5 Public water supply	8 Air conditioning	11 Injection well
1 Domestic	3 Feedlot	6 Oil field water supply
2 Irrigation	4 Industrial	7 Lawn and garden only
		9 Dewatering
		10 Monitoring well
		12 Other (Specify below)

Was a chemical/bacteriological sample submitted to Department? Yes _____ No X; If yes, mo/day/yr sample was submitted _____

Water Well Disinfected? Yes X No _____

5 TYPE OF BLANK CASING USED:

1 Steel	3 RMP (SR)	5 Wrought iron	8 Concrete tile	CASING JOINTS: Glued <u>X</u> Clamped _____
2 PVC	4 ABS	6 Asbestos-Cement	9 Other (specify below)	Welded _____
		7 Fiberglass		Threaded _____

Blank casing diameter _____ 5" in. to 0-30 ft., Dia 5" in. to 60-99 ft., Dia _____ in. to _____ ft.

Casing height above land surface: 24" in., weight 2.82 lbs./ft. Wall thickness or gauge No. .258

TYPE OF SCREEN OR PERFORATION MATERIAL:

1 Steel	3 Stainless steel	5 Fiberglass	8 RMP (SR)	10 Asbestos-cement
2 Brass	4 Galvanized steel	6 Concrete tile	9 ABS	11 Other (specify) _____
				12 None used (open hole)

SCREEN OR PERFORATION OPENINGS ARE:

1 Continuous slot	3 Mill slot	5 Gauzed wrapped	8 Saw cut	11 None (open hole)
2 Louvered shutter	4 Key punched	6 Wire wrapped	9 Drilled holes	
		7 Torch cut	10 Other (specify) _____	

SCREEN-PERFORATED INTERVALS: From _____ 30 _____ ft. to _____ 60 _____ ft., From _____ ft. to _____ ft.

From _____ 99 _____ ft. to _____ 100 _____ ft., From _____ ft. to _____ ft.

GRAVEL PACK INTERVALS: From _____ 24 _____ ft. to _____ 100 _____ ft., From _____ ft. to _____ ft.

From _____ ft. to _____ ft., From _____ ft. to _____ ft.

6 GROUT MATERIAL: 1 Neat cement 2 Cement grout 3 Bentonite 4 Other _____

Grout Intervals: From _____ 4 _____ ft. to _____ 24 _____ ft., From _____ ft. to _____ ft., From _____ ft. to _____ ft.

What is the nearest source of possible contamination:

1 Septic tank	4 Lateral lines	7 Pit privy	10 Livestock pens	14 Abandoned water well
2 Sewer lines	5 Cess pool	8 Sewage lagoon	11 Fuel storage	15 Oil well/Gas well
3 Watertight sewer lines	6 Seepage pit	9 Feedyard	12 Fertilizer storage	16 Other (specify below)
			13 Insecticide storage	

Direction from well? south How many feet? 200'

FROM	TO	LITHOLOGIC LOG	FROM	TO	PLUGGING INTERVALS
0	10	Clay-Brown			
10	14	Shale-Yellow			
14	33	Shale-Grey			
33	46	Sandstone-Grey			
46	50	Limestone-Grey			
50	52	Shale-Grey			
52	53	Limestone-Grey			
53	54	Shale-Grey			
54	56	Limestone-Grey			
56	58	Shale-Grey			
58	67	Limestone-grey			
67	69	Shale-Grey			
69	76	Limestone-Grey			
76	100	Shale-Grey			

7 CONTRACTOR'S OR LANDOWNER'S CERTIFICATION: This water well was (1) constructed, (2) reconstructed, or (3) plugged under my jurisdiction and was completed on (mo/day/year) _____ 9-18-92 _____ and this record is true to the best of my knowledge and belief. Kansas Water Well Contractor's License No. _____ 182 _____ This Water Well Record was completed on (mo/day/yr) _____ 10-8-92 _____ under the business name of STRADER DRILLING CO., INC. by (signature) [Signature]

INSTRUCTIONS: Use typewriter or ball point pen. PLEASE PRESS FIRMLY and PRINT clearly. Please fill in blanks, underline or circle the correct answers. Send top three copies to Kansas Department of Health and Environment, Bureau of Water, Topeka, Kansas 66620-0001. Telephone: 913-296-5545. Send one to WATER WELL OWNER and retain one for your records.

OFFICE USE ONLY