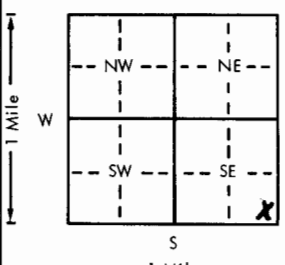
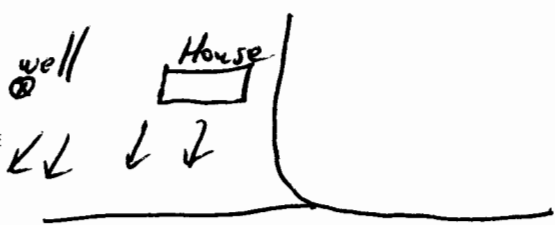


USE TYPEWRITER OR BALL
POINT PEN-PRESS FIRMLY,
PRINT CLEARLY.

WATER WELL RECORD
KSA 82a-1201-1215

Kansas Department of Health and
Environment-Division of Environment
(Water well Contractors)
Topeka, Kansas 66620

1. Location of well: County <u>Osage</u>		Fraction <u>1/4 SE 1/4 SE 1/4</u>	Section number <u>15</u>	Township number <u>T 14 S</u>	Range number <u>R 15 E</u>
2. Distance and direction from nearest town or city: <u>1 1/2 west of Carbondale</u>		3. Owner of well: <u>Palmer D. Robb</u> R.R. or street: <u>4821 West 81st</u> City, state, zip code: <u>Topeka KS.</u>			
4. Locate with "X" in section below: 		Sketch map: 		6. Bore hole dia. <u>6 1/2</u> in. Completion date <u>2-6-78</u> Well depth <u>149</u> ft.	
5. Type and color of material		From	To	7. <input checked="" type="checkbox"/> Cable tool <input type="checkbox"/> Rotary <input type="checkbox"/> Driven <input type="checkbox"/> Dug <input type="checkbox"/> Hollow rod <input type="checkbox"/> Jetted <input type="checkbox"/> Bored <input type="checkbox"/> Reverse rotary	
<u>Top So. l</u>		<u>0</u>	<u>2</u>	8. Use: <input checked="" type="checkbox"/> Domestic <input type="checkbox"/> Public supply <input type="checkbox"/> Industry <input type="checkbox"/> Irrigation <input type="checkbox"/> Air conditioning <input type="checkbox"/> Stock <input type="checkbox"/> Lawn <input type="checkbox"/> Oil field water <input type="checkbox"/> Other	
<u>Clay yellow</u>		<u>2</u>	<u>20</u>	9. Casing: Material <u>PITS</u> Height: Above or below Threaded <input type="checkbox"/> Welded <input type="checkbox"/> Surface <u>24</u> in. RMP <input checked="" type="checkbox"/> PVC <input type="checkbox"/> Weight <input type="checkbox"/> lbs./ft. Dia. <u>5</u> in. to <u>149</u> ft. depth Wall Thickness: inches or Dia. <input type="checkbox"/> in. to <input type="checkbox"/> ft. depth gage No. <u>200</u>	
<u>Shale grey</u>		<u>20</u>	<u>23</u>	10. Screen: Manufacturer's name <u>Sunflower</u> Type <u>RMP</u> Dia. <u>5 1/2</u> Slot/gauze <u>2/16</u> Length <u>19 1/2</u> Set between <u>130</u> ft. and <u>149</u> ft. <input type="checkbox"/> ft. and <input type="checkbox"/> ft. Gravel pack? <u>No</u> Size range of material <input type="checkbox"/>	
<u>Lime</u>		<u>23</u>	<u>26</u>	11. Static water level: <input type="checkbox"/> mo./day/yr. <u>75</u> ft. below land surface Date <u>2-6-78</u>	
<u>Shale grey</u>		<u>26</u>	<u>33</u>	12. Pumping level below land surfaces: <input type="checkbox"/> ft. after <input type="checkbox"/> hrs. pumping <input type="checkbox"/> g.p.m. <input type="checkbox"/> ft. after <input type="checkbox"/> hrs. pumping <input type="checkbox"/> g.p.m. Estimated maximum yield <u>1-2</u> g.p.m.	
<u>Lime</u>		<u>33</u>	<u>61</u>	13. Water sample submitted: <input type="checkbox"/> mo./day/yr. <input type="checkbox"/> Yes <input checked="" type="checkbox"/> No Date <u>2-6-78</u>	
<u>Shale grey sticky</u>		<u>61</u>	<u>91</u>	14. Well head completion: <input checked="" type="checkbox"/> Pitless adapter <input type="checkbox"/> Inches above grade	
<u>Shale sandy</u>		<u>91</u>	<u>95</u>	15. Well grouted? <u>yes</u> With: <input checked="" type="checkbox"/> Neat cement <input type="checkbox"/> Bentonite <input type="checkbox"/> Concrete Depth: From <u>0</u> ft. to <u>84</u> ft.	
<u>Shale sandy in spots</u>		<u>95</u>	<u>130</u>	16. Nearest source of possible contamination: ft. <u>100</u> Direction <u>South</u> Type <u>Septic</u> Well disinfected upon completion? <input checked="" type="checkbox"/> Yes <input type="checkbox"/> No	
<u>Lime Hard</u>		<u>130</u>	<u>140</u>	17. Pump: <input type="checkbox"/> Not installed Manufacturer's name <u>Facuzzi</u> Model number <u>3844</u> HP <u>1 1/2</u> Volts <u>230</u> Length of drop pipe <u>148</u> ft. capacity <u>2</u> g.p.m. Type: <input checked="" type="checkbox"/> Submersible <input type="checkbox"/> Turbine <input type="checkbox"/> Jet <input type="checkbox"/> Reciprocating <input type="checkbox"/> Centrifugal <input type="checkbox"/> Other	
<u>Sandy shale</u>		<u>140</u>	<u>142</u>	20. Water well contractor's certification: This well was drilled under my jurisdiction and this report is true to the best of my knowledge and belief. <u>Robison Drilling 316</u> Business name <u>Perry KS</u> License No. <u>3678</u> Address <u>Perry KS</u> Signed <u>Jack Robison</u> Date <u>2-6-78</u> Authorized representative	
<u>Sandstone grey</u>		<u>142</u>	<u>147</u>		
<u>Lime</u>		<u>147</u>	<u>149</u>		
(Use a second sheet if needed)					
18. Elevation: Topography: <input type="checkbox"/> Hill <input type="checkbox"/> Slope <input type="checkbox"/> Upland <input type="checkbox"/> Valley		19. Remarks: <u>owner to install slab</u>			