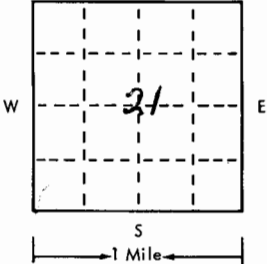
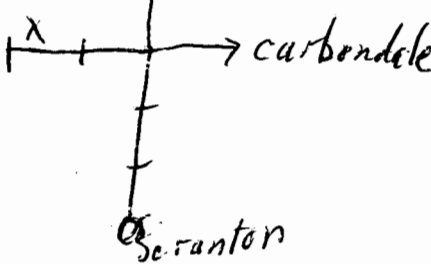


USE TYPEWRITER OR BALL  
POINT PEN-PRESS FIRMLY,  
PRINT CLEARLY.

WATER WELL RECORD  
KSA 82a-1201-1215

T R EW sec 1/4 1/4 1/4 No.

Kansas State Dept. Of Health  
(Water Well Contractors)  
Forbes-Bldg. 740  
Topeka, Kansas 66620

1 Location of well:	County <b>Osage</b>	Township name	Fraction <b>SW 1/4 SW 1/4 SW 1/4</b>	Section number <b>21</b>	Town number <b>14</b>	Range number <b>15</b>													
Distance and direction from nearest town or city:				3 Owner of well: <b>Jim Rawter</b>															
Street address of well location if in city:				Address: <b>Seranton, Kans.</b>															
Locate with "X" in section below: N 		Sketch map: 		4 Well depth: <b>201</b> ft. Date of completion <b>Sept 5</b> Well diameter <b>6</b> in.															
2		Type and color of material		From		To		5 <input checked="" type="checkbox"/> Cable tool <input type="checkbox"/> Rotary <input type="checkbox"/> Driven <input type="checkbox"/> Dug <input type="checkbox"/> Hollow rod <input type="checkbox"/> Jetted <input type="checkbox"/> Bored <input type="checkbox"/> Reverse rotary											
								6 Use: <input checked="" type="checkbox"/> Domestic <input type="checkbox"/> Public supply <input type="checkbox"/> Industry <input type="checkbox"/> Irrigation <input type="checkbox"/> Air conditioning <input type="checkbox"/> Commercial <input type="checkbox"/> Test well <input type="checkbox"/>											
								7 Casing: Material <b>Styrene</b> Height: above/below Threaded <input type="checkbox"/> Welded <input type="checkbox"/> Surface <b>24</b> in. Diam. <b>3</b> in. to <b>201</b> ft. depth Drive shoe? <input type="checkbox"/> Yes <input type="checkbox"/> No <b>5</b> in. to <b>201</b> ft. depth											
								8 Screen: <b>Field</b> Manufacturer <b>Styrene</b> Dia. <b>5</b> Slot/gauze <b>1/4</b> Length <b>1/4</b> Set between <b>25</b> ft. and <b>300</b> ft. Fittings: Gravel pack <input type="checkbox"/> Yes <input checked="" type="checkbox"/> No Size range of material											
(use a second sheet if needed)		9 Static water level: <b>40</b> ft. below land surface Date <b>9/5</b>		10 Pumping level below land surfaces: <b>Ball Test</b> ____ ft. after ____ hrs. pumping ____ g.p.m. ____ ft. after ____ hrs. pumping ____ g.p.m. Estimated maximum yield <b>2</b> g.p.m.		11 Water sample submitted: <input type="checkbox"/> Yes <input checked="" type="checkbox"/> No Date		12 Well head completion: <input type="checkbox"/> Pitless adapter <input checked="" type="checkbox"/> 4 inches above grade											
										13 Well grouted? <input checked="" type="checkbox"/> Yes <input type="checkbox"/> No <input type="checkbox"/> Neat cement <input type="checkbox"/> Bentonite <input type="checkbox"/> Depth: From <b>0</b> ft. to <b>22</b> ft.									
												14 Nearest source of possible contamination: <b>200 ft</b> Direction <b>SW</b> Type <b>Lagoon</b> Well disinfected upon completion? <input checked="" type="checkbox"/> Yes <input type="checkbox"/> No							
														15 Pump: <input type="checkbox"/> Not installed Manufacturer's name _____ Model number _____ HP _____ Volts _____ Length of drop pipe _____ ft. capacity _____ g.m.p. Type: <input type="checkbox"/> Submersible <input type="checkbox"/> Turbine <input type="checkbox"/> Jet <input type="checkbox"/> Reciprocating <input type="checkbox"/> Centrifugal <input type="checkbox"/> Other					
																16 Remarks: elevation <b>1121</b> <b>Owner to install slab</b> Topography: <input type="checkbox"/> Hill <input type="checkbox"/> Slope <input checked="" type="checkbox"/> Upland <input type="checkbox"/> Valley			
																		17 Water well contractor's certification: This well was drilled under my jurisdiction and this report is true to the best of my knowledge and belief. <b>Robison Drilling</b> Business name <b>Carbondale, KS</b> License No. _____ Address _____ Signed <b>Paul Wilkerson</b> Date <b>9/5/75</b> Authorized representative	

14 15E 21 SW SW SW