

OFFICE USE ONLY

T

R

EW

SEC.

1/4

1/4

1/4

1/4

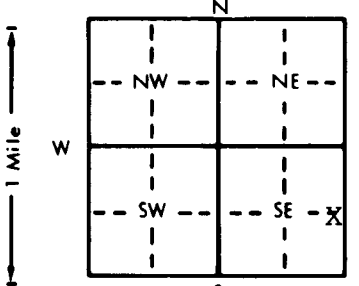
1/4

1/4

1 LOCATION OF WATER WELL: Fraction NE 1/4 SE 1/4 SE 1/4 Section Number 22 Township Number T 14 S Range Number R 15 EW

Distance and direction from nearest town or city street address of well if located within city?
 1 1/2 west of Carbondale

2 WATER WELL OWNER: Allan Bingham
 RR#, St. Address, Box #: 310 Wilson Board of Agriculture, Division of Water Resources
 City, State, ZIP Code: Carbondale, KS 66414 Application Number:

3 LOCATE WELL'S LOCATION WITH AN "X" IN SECTION BOX:  4 DEPTH OF COMPLETED WELL: 140' ft. ELEVATION: ...
 Depth(s) Groundwater Encountered 1. 105' ft. 2. ... ft. 3. ... ft.
 WELL'S STATIC WATER LEVEL . 82' ft. below land surface measured on mo/day/yr 3-08-94
 Pump test data: Well water was ... ft. after ... hours pumping ... gpm
 Est. Yield . 10 ... gpm: Well water was ... ft. after ... hours pumping ... gpm
 Bore Hole Diameter . 8 3/4 . in. to ... ft., and ... in. to ... ft.
 WELL WATER TO BE USED AS: 5 Public water supply 8 Air conditioning 11 Injection well
 1 Domestic 3 Feedlot 6 Oil field water supply 9 Dewatering 12 Other (Specify below)
 2 Irrigation 4 Industrial 7 Lawn and garden only 10 Monitoring well
 Was a chemical/bacteriological sample submitted to Department? Yes ... No X; If yes, mo/day/yr sample was submitted
 Water Well Disinfected? Yes X No

5 TYPE OF BLANK CASING USED: 5 Wrought iron 8 Concrete tile CASING JOINTS: Glued X Clamped
 1 Steel 3 RMP (SR) 6 Asbestos-Cement 9 Other (specify below) Welded
 2 PVC 4 ABS 7 Fiberglass Threaded
 Blank casing diameter . 5" . in. to 0-80 . ft., Dia . 5" . in. to 120-140 . ft., Dia . . in. to . ft.
 Casing height above land surface . 24" . in., weight . 2.82 . lbs./ft. Wall thickness or gauge No. . 258
 TYPE OF SCREEN OR PERFORATION MATERIAL: 7 PVC 10 Asbestos-cement
 1 Steel 3 Stainless steel 5 Fiberglass 8 RMP (SR) 11 Other (specify)
 2 Brass 4 Galvanized steel 6 Concrete tile 9 ABS 12 None used (open hole)
 SCREEN OR PERFORATION OPENINGS ARE: 5 Gauzed wrapped 8 Saw cut 11 None (open hole)
 1 Continuous slot 3 Mill slot 6 Wire wrapped 9 Drilled holes
 2 Louvered shutter 4 Key punched 7 Torch cut 10 Other (specify)
 SCREEN-PERFORATED INTERVALS: From . 80 . ft. to . 120 . ft., From . ft. to . ft.
 From . ft. to . ft., From . ft. to . ft.
 GRAVEL PACK INTERVALS: From . 24 . ft. to . 140 . ft., From . ft. to . ft.
 From . ft. to . ft., From . ft. to . ft.

6 GROUT MATERIAL: 1 Neat cement 2 Cement grout 3 Bentonite 4 Other
 Grout Intervals: From . 4 . ft. to . 24 . ft., From . ft. to . ft., From . ft. to . ft.
 What is the nearest source of possible contamination: 10 Livestock pens 14 Abandoned water well
 1 Septic tank 4 Lateral lines 7 Pit privy 11 Fuel storage 15 Oil well/Gas well
 2 Sewer lines 5 Cess pool 8 Sewage lagoon 12 Fertilizer storage 16 Other (specify below)
 3 Watertight sewer lines 6 Seepage pit 9 Feedyard 13 Insecticide storage
 Direction from well? south How many feet? 250'

FROM	TO	LITHOLOGIC LOG	FROM	TO	PLUGGING INTERVALS
0	2	Top Soil			
2	7	Clay-Brown			
7	24	Shale-Yellow			
24	33	Limestone-Grey			
33	49	Shale-Grey			
49	52	Sandstone-Grey			
52	93	Shale-Grey			
93	95	Shale-Black			
95	97	Limestone-Grey			
97	103	Shale-Grey			
103	105	Limestone-Tan-Loose			
105	107	Shale-Grey			
107	121	Limestone-Grey			
121	140	Shale-Grey			

7 CONTRACTOR'S OR LANDOWNER'S CERTIFICATION: This water well was (1) constructed, (2) reconstructed, or (3) plugged under my jurisdiction and was completed on (mo/day/year) 3-08-94 and this record is true to the best of my knowledge and belief. Kansas Water Well Contractor's License No 182 This Water Well Record was completed on (mo/day/yr) 4-18-94 under the business name of STRADER DRILLING CO., INC. by (signature) Dale Skerren