

CORRECTION(S) TO WATER WELL RECORD (WWC-5)

(to rectify lacking or incorrect information)

County: Douglas

Location listed as:

Location changed to:

Section-Township-Range: 15-145-18E

13-145-17E

Fraction ($\frac{1}{4}$ $\frac{1}{4}$ $\frac{1}{4}$): SW SW NE

SW SW NE

Other changes: Initial statements: _____

Changed to: _____

Comments: _____


verification method: Written description, county ownership directory,
position on plat map, and mapping tool & aerial photo
on KGS website initials: ORA date: 6/25/2008

1 LOCATION OF WATER WELL: County: Douglas Fraction: SW 1/4 SW 1/4 NE 1/4 Section Number: 15 Township Number: T 14 S Range Number: R 18 EW

Distance and direction from nearest town or city street address of well if located within city?
3 North 3 1/4 West 1/2 North Globe, Kan.

2 WATER WELL OWNER: RR#, St. Address, Box # : Wayne Morrison Board of Agriculture, Division of Water Resources
 City, State, ZIP Code : Lawrence Kans. Application Number:

3 LOCATE WELL'S LOCATION WITH AN "X" IN SECTION BOX: 4 DEPTH OF COMPLETED WELL: 255 ft. ELEVATION: 1559.7 ft.

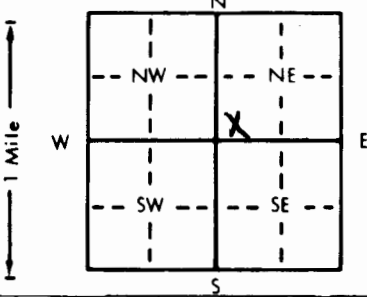

Depth(s) Groundwater Encountered 1. 197 ft. 2. 255 ft. 3. 255 ft.
 WELL'S STATIC WATER LEVEL 1559.7 ft. below land surface measured on mo/day/yr
 WELL WATER TO BE USED AS: 5 Public water supply 11 Injection well
 1 Domestic 3 Feedlot 6 Oil field water supply 9 Dewatering 12 Other (Specify below) Heat Pump Hole
 2 Irrigation 4 Industrial 7 Lawn and garden only 10 Monitoring well
 Was a chemical/bacteriological sample submitted to Department? Yes No If yes, mo/day/yr sample was submitted
 Water Well Disinfected? Yes No

5 TYPE OF BLANK CASING USED: 1 Steel 3 RMP (SR) 5 Wrought iron 8 Concrete tile CASING JOINTS: Glued Clamped
 2 PVC 4 ABS 6 Asbestos-Cement 9 Other (specify below) Welded
 7 Fiberglass open hole Threaded


TYPE OF SCREEN OR PERFORATION MATERIAL: 1 Steel 3 Stainless steel 5 Fiberglass 8 RMP (SR) 10 Asbestos-cement
 2 Brass 4 Galvanized steel 6 Concrete tile 9 ABS 11 Other (specify) open hole
 12 None used (open hole)

SCREEN OR PERFORATION OPENINGS ARE: 1 Continuous slot 3 Mill slot 5 Gauzed wrapped 8 Saw cut 11 None (open hole)
 2 Louvered shutter 4 Key punched 6 Wire wrapped 9 Drilled holes
 7 Torch cut 10 Other (specify)


6 GROUT MATERIAL: 1 Neat cement 2 Cement grout 3 Bentonite 4 Other None

What is the nearest source of possible contamination: 1 Septic tank 4 Lateral lines 7 Pit privy 10 Livestock pens 14 Abandoned water well
 2 Sewer lines 5 Cess pool 8 Sewage lagoon 11 Fuel storage 15 Oil well/Gas well
 3 Watertight sewer lines 6 Seepage pit 9 Feedyard 12 Fertilizer storage 16 Other (specify below) None
 13 Insecticide storage

Direction from well? None How many feet? None

FROM	TO	LITHOLOGIC LOG	FROM	TO	PLUGGING INTERVALS
0	2	Soil			Customer put pipe in hole & filled it himself
2	18	Shaly Rock			
18	21	Black shale			
21	23	Lime			
23	44	Shale			
44	65	Lime			
65	194	gray sand shale			
194	197	Lime			
197	212	hard grey sandstone			
212	255	grey sand shale			

7 CONTRACTOR'S OR LANDOWNER'S CERTIFICATION: This water well was (1) constructed, (2) reconstructed, or (3) plugged under my jurisdiction and was completed on (mo/day/year) 9-10-90 and this record is true to the best of my knowledge and belief. Kansas Water Well Contractor's License No. 486 This Water Well Record was completed on (mo/day/yr) 10-2-90 under the business name of Edgar Swank Water Well Drilling (signature) Edgar Swank