

CORRECTION(S) TO WATER WELL RECORD (WWC-5)

(to rectify lacking or incorrect information)

County: Osage

Location listed as:

Location changed to:

Section-Township-Range: 30-14-17E

30-14S-17E

Fraction ($\frac{1}{4}$ $\frac{1}{4}$ $\frac{1}{4}$): SW

NW SW SW

Other changes: Initial statements: _____

Changed to: _____

Comments: _____

verification method: Legal description, position on plat map, county ownership map, and mapping tool & aerial photos on KGS website.


initials: DRJ date: 6/7/2006

submitted by: Kansas Geological Survey, Data Resources Library, 1930 Constant Ave., Lawrence, KS 66047-3726
to: Kansas Dept of Health & Environment, Bureau of Water, 1000 SW Jackson, Suite 420, Topeka, KS 66612-1367.

1 LOCATION OF WATER WELL:	Fraction	Section Number	Township Number	Range Number
County: <u>Osage</u>	$\frac{1}{4}$ <u>SW</u> $\frac{1}{4}$	<u>30</u>	<u>14</u>	<u>17</u> EW

Distance and direction from nearest town or city street address of well if located within city?

2 WATER WELL OWNER: Barbara Woodruff
13097 S Stubbs Rd
 RR #, St. Address, Box #: Overbrook KS 66524
 City, State, ZIP Code: Overbrook KS 66524
 Board of Agriculture, Division of Water Resources
 Application Number: _____

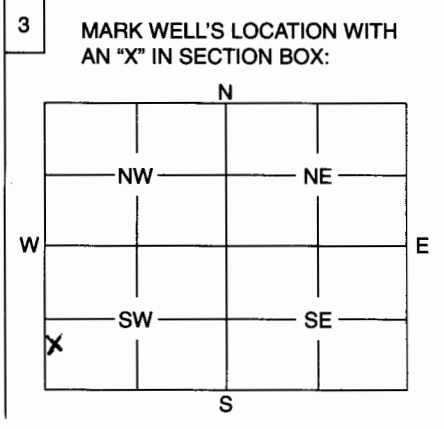

4 DEPTH OF WELL 19 ft.
 WELL'S STATIC WATER LEVEL 13 ft.

WELL WAS USED AS:

<input checked="" type="checkbox"/> 1 Domestic	5 Public Water Supply	9 Dewatering
2 Irrigation	6 Oil Field Water Supply	10 Monitoring Well
3 Feedlot	7 Domestic (Lawn & Garden)	11 Injection Well
4 Industrial	8 Air Conditioning	12 Other

Was a chemical / bacteriological sample submitted to Department? Yes No X
 If yes, mo/day/yr sample was submitted

Water Well Disinfected: Yes X No

5 TYPE OF BLANK CASING USED:

1 Steel	3 RMP (SR)	5 Wrought	7 Fiberglass	9 Other (Specify below) <u>Limestone rock</u>
2 PVC	4 ABS	6 Asbestos-Cement	8 Concrete Tile	

Blank casing diameter 60 in. Was casing pulled? Yes X No If yes, how much 60
 Casing height above or below land surface 60 in.

6 GROUT PLUG MATERIAL: 1 Neat cement 2 Cement grout 3 Bentonite 4 Other

Grout Plug Intervals: From 3 ft. to 4 ft., From ft. to ft., From to ft.

What is the nearest source of possible contamination:

1 Septic tank	6 Seepage pit	11 Fuel storage	16 Other (specify below)
2 Sewer lines	7 Pit privy	12 Fertilizer storage	
3 Watertight sewer lines	8 Sewage lagoon	13 Insecticide storage	
4 Lateral lines	9 Feedyard	14 Abandoned water well	
5 Cess pool	<input checked="" type="checkbox"/> <u>10</u> livestock pens	15 Oil well/Gas well	

Direction from well? NE How many feet? >500

FROM	TO	PLUGGING MATERIALS
<u>0</u>	<u>3</u>	<u>soil</u>
<u>3</u>	<u>4</u>	<u>bentonite</u>
<u>4</u>	<u>6</u>	<u>soil</u>
<u>6</u>	<u>19</u>	<u>sand</u>

7 CONTRACTOR'S OF LANDOWNER'S CERTIFICATION: This water well was plugged under my jurisdiction and was completed on (mo/day/year) and this record is true to the best of my knowledge and belief. Kansas Water Well Contractor's License No. This Water Well Record was completed on (mo/day/year) under the business name of
 by (signature) Tom Moon

INSTRUCTIONS: Use typewriter or ball point pen. Please press firmly and print clearly. Please fill in blanks, underline or circle the correct answers. Send top three copies to Kansas Department of Health and Environment, Bureau of Water, Geology Section, 1000 SW Jackson St., Ste. 420, Topeka, Kansas 66612-1367. Telephone: 785/296-5522. Send one to Water Well Owner and retain one for your records.