USE TYPEWRITER OR BALL POINT PEN-PRESS FIRMLY, PRINT CLEARLY.

T	R	EW	sec	1/4	1/4	1/4	No.

WATER WELL RECORD
KSA 82a-1201-1215

Kansas State Dept. Of Health
(Water Well Contractors)
Forbes-Bldg. 740
Topeka, Kansas 66620

20 Acres in

1 Location of well:	County	Township name	Fraction	Section number	Town number	Range number
	Osage		SW¼ SE¼ SW?	20	14S	17E

Distance and direction from nearest town or city: 2 mi North of Overbrook.

Street address of well location if in city:

3 Owner of well: Mike Goddard

Address: 3108 Grand Ct. Topeka, Ks.

Locate with "X" in section below:

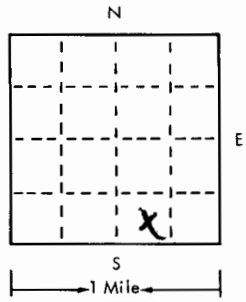

Sketch map:

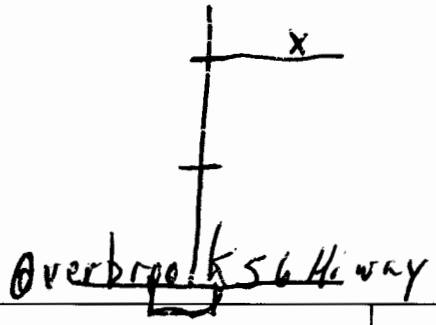

4 Well depth: 105 ft. Date of completion 4-12-76
Well diameter 5" in.

5 [X] Cable tool [ ] Rotary [ ] Driven [ ] Dug [ ] Hollow rod [ ] Jetted [ ] Bored [ ] Reverse rotary

6 Use: [X] Domestic [ ] Public supply [ ] Industry [ ] Irrigation [ ] Air conditioning [ ] Commercial [ ] Test well [ ]

7 Casing: Material Styrene Height: above/below
Threaded [ ] Welded [ ] Surface 36 in.
Diam. 5" in. to 105 ft. depth Weight ___ lbs./ft.
___ in. to ___ ft. depth Drive shoe? [ ] Yes [ ] No
0.200 WT

8 Screen:
Manufacturer Field Servicewell
Type Styrene Dia. 5"
Slot/gauge 3/16 Length 75'
Set between 30 ft. and 105 ft.
Fittings:
Gravel pack [ ] Yes [X] No Size range of material ___

9 Static water level:
75 ft. below land surface Date 4-12-76

10 Pumping level below land surfaces:
___ ft. after ___ hrs. pumping ___ g.p.m.
___ ft. after ___ hrs. pumping ___ g.p.m.
Estimated maximum yield 8-10 g.p.hour

11 Water sample submitted:
[ ] Yes [X] No Date ___

12 Well head completion:
[ ] Pitless adapter 36 inches above grade

13 Well grouted? [X] Yes [ ] No
[X] Neat cement [ ] Bentonite [ ]
Depth: From 0 ft. to 25 ft.

14 Nearest source of possible contamination:
ft. 100 Direction North Type Septic
Well disinfected upon completion? [X] Yes [ ] No

15 Pump: [X] Not installed
Manufacturer's name ___
Model number ___ HP ___ Volts ___
Length of drop pipe ___ ft. capacity ___ g.m.p.
Type:
[ ] Submersible [ ] Turbine
[ ] Jet [ ] Reciprocating
[ ] Centrifugal [ ] Other

2 Type and color of material	From	To
Clay yellow & Broken Lime	0	15
shale grey	15	69
Shale grey & Broken Lime	69	105

(use a second sheet if needed)

16 Remarks: elevation
owner to install slab.

Topography:
[X] Hill
[ ] Slope
[X] Upland
[ ] Valley

17 Water well contractor's certification:
This well was drilled under my jurisdiction and this report is true to the best of my knowledge and belief.
Business name Robison Drilling License No. 216-17
Address Perry Ks.
Signed Jack Robison Authorized representative Date 4-12-76

14 17E 20 SWSE

Forward the white, blue and pink copies to the Kansas State Dept. Of Health.

Form WWC-5