

WATER WELL PLUGGING RECORD Form WWC-5P

KSA 82a-1212

ID NO.

1 LOCATION OF WATER WELL: County: DOUGLAS	Fraction SE ¼ SW ¼ SE ¼ ¼	Section Number 11	Township Number T 14 S	Range Number 17 ☒ E ☐ W
--	------------------------------	----------------------	---------------------------	---


Street/Rural Address of Well Location; if unknown, distance & direction from nearest town or intersection: If at owner's address, check here ☒ 400 FEET EAST OF ADDRESS
59 N 700 ROAD
OVERBROOK, KS 66524, NORTH DITCH

Global Positioning Systems (GPS) information:
Latitude: N38.840552 (in decimal degrees)
Longitude: W95.487990 (in decimal degrees)
Elevation:
Horizontal Datum: ☒ WGS84, ☐ NAD83, ☐ NAD27
Collection Method:

2 WATER WELL OWNER: DOUGLAS COUNTY, KS
RR#, St. Address, Box #: RIGHT OF WAY
City, State ZIP Code:

☐ GPS unit (Make/Model: _____)
☒ Digital Map/Photo, ☐ Topographic Map, ☐ Land Survey
Est. Accuracy: ☐ < 3 m, ☒ 3-5 m, ☐ 5-15 m, ☐ > 15 m

3 MARK WELL'S LOCATION WITH AN "X" IN SECTION BOX:

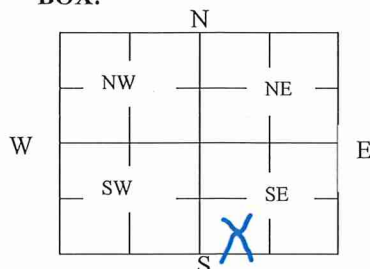

4 DEPTH OF WELL 7 ft.

WELL'S STATIC WATER LEVEL 4 ft

WELL WAS USED AS:

- | | | |
|--|---|---|
| ☒ Domestic | ☐ Public Water Supply | ☐ Dewatering |
| ☐ Irrigation | ☐ Oil Field Water Supply | ☐ Monitoring |
| ☐ Feedlot | ☐ Domestic (Lawn & Garden) | ☐ Injection Well |
| ☐ Industrial | ☐ Air Conditioning | ☐ Other _____ |

Was a chemical/bacteriological sample submitted to Department? Yes ☐ No ☐

5 TYPE OF BLANK CASING USED:

- ☐ Steel ☐ RMP (SR) ☐ Wrought ☐ Fiberglass ☒ Other (Specify below)
☐ PVC ☐ ABS ☐ Asbestos-Cement ☐ Concrete Tile LIMESTONE

Blank casing diameter 53 in. Was casing pulled? Yes ☒ No ☐ If yes, how much TOP 18"
Casing height above or below land surface 18 in.

6 GROUT PLUG MATERIAL: ☐ Neat cement ☐ Cement grout ☐ Bentonite ☒ Other BAGGED CONCRETE

Grout Plug Intervals: From 2 ft. to 7 ft., From _____ ft. to _____ ft., From _____ ft. to _____ ft.

What is the nearest source of possible contamination:

- | | | | |
|---|---|---|--|
| ☐ Septic tank | ☐ Seepage pit | ☐ Fuel storage | ☐ Other (specify below) _____
Direction from well? _____
How many feet? _____ |
| ☐ Sewer lines | ☐ Pit privy | ☐ Fertilizer storage | |
| ☐ Watertight sewer lines | ☐ Sewage lagoon | ☐ Insecticide storage | |
| ☐ Lateral lines | ☐ Feedyard | ☐ Abandoned water well | |
| ☐ Cess pool | ☐ Livestock pens | ☐ Oil well/Gas well | |

FROM	TO	PLUGGING MATERIALS	FROM	TO	PLUGGING MATERIALS
0	2' - 0"	BLACK TOPSOIL			
2' - 0"	3' - 0"	COMPACTED CLAY			
3' - 0"	4' - 0"	CONCRETE CAP			
4' - 0"	7' - 0"	CHLORINATED SAND			

7 CONTRACTOR'S OR LANDOWNER'S CERTIFICATION: This water well was plugged under my jurisdiction and was completed on (mo/day/year) 06/25/24 and this record is true to the best of my knowledge and belief. Kansas Water Well Contractor's License No. _____. This Water Well Record was completed on (mo/day/year) 06/26/24 under the business name of DOUGLAS COUNTY PUBLIC WORKS by (signature) *Paul Gun*

Send one white copy to Kansas Department of Health & Environment, Geology Section, 1000 SW Jackson Street, Ste. 420, Topeka, KS 66612-1367. Send one copy to WATER WELL OWNER and retain one for your records.
Visit us at <http://www.kdheks.gov/waterwell/index.html> Telephone 785-296-5524.

KSA82a-1212

Revised 1/20/2015