


1 LOCATION OF WATER WELL: County: Dickinson Fraction: NW 1/4 NE 1/4 SW 1/4 Section Number: 2 Township Number: T 14 S Range Number: R 2 EAW

Distance and direction from nearest town or city street address of well if located within city?  
3 miles South of Abilene, Ks on Hwy 15 1 3/4 miles East & 1/2 South & 3/8 mile East

2 WATER WELL OWNER: Steve ~~Schwartz~~ Schwarting  
 RR#, St. Address, Box #: Rt 2 Board of Agriculture, Division of Water Resources  
 City, State, ZIP Code: Abilene, Kansas 67410 Application Number:

3 LOCATE WELL'S LOCATION WITH AN "X" IN SECTION BOX:

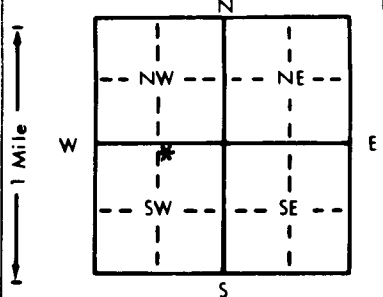

4 DEPTH OF COMPLETED WELL: 74 ft. ELEVATION:  
 Depth(s) Groundwater Encountered 1. 65 ft. 2. ft. 3. ft.  
 WELL'S STATIC WATER LEVEL: 48 ft. below land surface measured on mo/day/yr 2 / 6 / 91  
 Pump test data: Well water was ft. after hours pumping gpm  
 Est. Yield: 20+ gpm: Well water was ft. after hours pumping gpm  
 Bore Hole Diameter: 9 in. to 74 ft., and in. to ft.  
 WELL WATER TO BE USED AS: 5 Public water supply 8 Air conditioning 11 Injection well  
 1 Domestic 3 Feedlot 6 Oil field water supply 9 Dewatering 12 Other (Specify below)  
 2 Irrigation 4 Industrial 7 Lawn and garden only 10 Monitoring well  
 Was a chemical/bacteriological sample submitted to Department? Yes.....No \*; If yes, mo/day/yr sample was submitted  
 Water Well Disinfected? Yes \* No

5 TYPE OF BLANK CASING USED:  
 1 Steel 3 RMP (SR) 5 Wrought iron 8 Concrete tile CASING JOINTS: Glued \* Clamped  
 2 PVC 4 ABS 6 Asbestos-Cement 9 Other (specify below) Welded  
 7 Fiberglass Threaded

Blank casing diameter: 5 in. to 74 ft., Dia. in. to ft., Dia. in. to ft.  
 Casing height above land surface: 13 in., weight: 200 lbs./ft. Wall thickness or gauge No.

TYPE OF SCREEN OR PERFORATION MATERIAL:  
 1 Steel 3 Stainless steel 5 Fiberglass 7 PVC 10 Asbestos-cement  
 2 Brass 4 Galvanized steel 6 Concrete tile 8 RMP (SR) 11 Other (specify)  
 9 ABS 12 None used (open hole)

SCREEN OR PERFORATION OPENINGS ARE:  
 1 Continuous slot 3 Mill slot 5 Gauzed wrapped 8 Saw cut 11 None (open hole)  
 2 Louvered shutter 4 Key punched 6 Wire wrapped 9 Drilled holes  
 7 Torch cut 10 Other (specify)

SCREEN-PERFORATED INTERVALS: From 50 ft. to 74 ft., From ft. to ft.  
 From ft. to ft., From ft. to ft.  
 GRAVEL PACK INTERVALS: From 23 ft. to 74 ft., From ft. to ft.  
 From ft. to ft., From ft. to ft.

6 GROUT MATERIAL: 1 Neat cement 2 Cement grout 3 Bentonite 4 Other  
 Grout Intervals: From 3 ft. to 23 ft., From ft. to ft., From ft. to ft.

What is the nearest source of possible contamination:  
 1 Septic tank 4 Lateral lines 7 Pit privy 10 Livestock pens 14 Abandoned water well  
 2 Sewer lines 5 Cess pool 8 Sewage lagoon 11 Fuel storage 15 Oil well/Gas well  
 3 Watertight sewer lines 6 Seepage pit 9 Feedyard 12 Fertilizer storage 16 Other (specify below)  
 13 Insecticide storage  
 Direction from well? WEST How many feet? 210

FROM	TO	LITHOLOGIC LOG	FROM	TO	PLUGGING INTERVALS
0	6	BROWN CLAY			
6	23	LITE COLOR CLAY			
23	30	LITE COLOR HARD LIMESTONE			
30	32	DARK LIMESTONE			
32	37	LITE COLOR SHALE			
37	39	GRAY SHALE			
39	42	LITE CLOR LIMESTONE			
42	48	LITE GRAY SHALE			
48	65	RED SHALE			
65	74	GRAY SHALE			

7 CONTRACTOR'S OR LANDOWNER'S CERTIFICATION: This water well was (1) constructed, (2) reconstructed, or (3) plugged under my jurisdiction and was completed on (mo/day/year) 2 / 6 / 91 and this record is true to the best of my knowledge and belief. Kansas Water Well Contractor's License No. 397. This Water Well Record was completed on (mo/day/yr) 2 / 26 / 91 under the business name of CENTRAL KANSAS DRILLING by (signature) Harold D. Martin

22-50012301-22