


1 LOCATION OF WATER WELL: Fraction NW 1/4 SE 1/4 NW 1/4 Section Number 4 Township Number T 14 S Range Number R 2 E
 County: Dickinson

Distance and direction from nearest town or city street address of well if located within city?
3 1/2 miles south of Abilene, Kansas on HWY 15

2 WATER WELL OWNER: Dale Rappth
 RR#, St. Address, Box # : 513 S.E. 6
 City, State, ZIP Code : Abilene, Kansas 67410
 Board of Agriculture, Division of Water Resources
 Application Number:

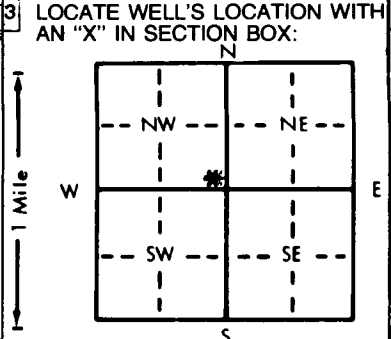

4 DEPTH OF COMPLETED WELL: 90 ft. ELEVATION:ft.
 Depth(s) Groundwater Encountered 1. 52 ft. 2.ft. 3.ft.
 WELL'S STATIC WATER LEVEL 48 ft. below land surface measured on mo/day/yr 5/23/86
 Pump test data: Well water wasft. after hours pumping gpm
 Est. Yield 5 gpm: Well water wasft. after hours pumping gpm
 Bore Hole Diameter 9 in. to 90 ft., and in. toft.
 WELL WATER TO BE USED AS: 5 Public water supply 8 Air conditioning 11 Injection well
1 Domestic 3 Feedlot 6 Oil field water supply 9 Dewatering 12 Other (Specify below)
 2 Irrigation 4 Industrial 7 Lawn and garden only 10 Observation well
 Was a chemical/bacteriological sample submitted to Department? Yes.....No.....*.....; If yes, mo/day/yr sample was submitted
 Water Well Disinfected? Yes * No

5 TYPE OF BLANK CASING USED: 5 Wrought iron 8 Concrete tile CASING JOINTS: Glued * Clamped
 1 Steel 3 RMP (SR) 6 Asbestos-Cement 9 Other (specify below) Welded
2 PVC 4 ABS 7 Fiberglass Threaded
 Blank casing diameter 5 in. to 90 ft., Dia in. toft., Dia in. toft.
 Casing height above land surface 15 in., weight 160 lbs./ft. Wall thickness or gauge No. 214
 TYPE OF SCREEN OR PERFORATION MATERIAL: 7 PVC 10 Asbestos-cement
 1 Steel 3 Stainless steel 5 Fiberglass 8 RMP (SR) 11 Other (specify)
 2 Brass 4 Galvanized steel 6 Concrete tile 9 ABS 12 None used (open hole)
 SCREEN OR PERFORATION OPENINGS ARE: 5 Gauzed wrapped 8 Saw cut 11 None (open hole)
 1 Continuous slot 3 Mill slot 6 Wire wrapped 9 Drilled holes
 2 Louvered shutter 4 Key punched 7 Torch cut 10 Other (specify)
 SCREEN-PERFORATED INTERVALS: From 50 ft. to 90 ft., Fromft. toft.
 Fromft. toft., Fromft. toft.
 GRAVEL PACK INTERVALS: From 14 ft. to 90 ft., Fromft. toft.
 Fromft. toft., Fromft. toft.

6 GROUT MATERIAL: 1 Neat cement 2 Cement grout 3 Bentonite 4 Other
 Grout Intervals: From 4 ft. to 14 ft., Fromft. toft., Fromft. toft.
 What is the nearest source of possible contamination:
 1 Septic tank 4 Lateral lines 7 Pit privy 10 Livestock pens 14 Abandoned water well
 2 Sewer lines 5 Cess pool 8 Sewage lagoon 11 Fuel storage 15 Oil well/Gas well
 3 Watertight sewer lines 6 Seepage pit 9 Feedyard 12 Fertilizer storage 16 Other (specify below)
 13 Insecticide storage
 Direction from well? NORTH How many feet? 125

FROM	TO	LITHOLOGIC LOG	FROM	TO	LITHOLOGIC LOG
0	1	TOPSOIL			
1	3	LIGHT COLOR CLAY & SHALE			
3	5	SH ALE & LIMESTONE			
5	50	LIGHT COLOR CLAY & SHALE			
50	51	LIMESTONE SOFT			
51	60	LITE COLOR SHALE			
60	63	RED CLAY & SHALE			
63	89	LITE COLOR SHALE & CLAY			
89	90	LIMEST ONE & GYPSUM ROCK			

7 CONTRACTOR'S OR LANDOWNER'S CERTIFICATION: This water well was (1) constructed, (2) reconstructed, or (3) plugged under my jurisdiction and was completed on (mo/day/year) 5/23/86 and this record is true to the best of my knowledge and belief. Kansas Water Well Contractor's License No. 397. This Water Well Record was completed on (mo/day/yr) 6/5/86 under the business name of CENTRAL KANSAS DRILLING by (signature) Harold D. Maston
 INSTRUCTIONS: Use typewriter or ball point pen, PLEASE PRESS FIRMLY and PRINT clearly. Please fill in blanks, underline or circle the correct answers. Send top three copies to Kansas Department of Health and Environment, Division of Environment, Environmental Geology Section, Topeka, KS 66620. Send one to WATER WELL OWNER and retain one for your records.