


USE TYPEWRITER OR BALL POINT PEN-PRESS FIRMLY, PRINT CLEARLY.

WATER WELL RECORD
KSA 82a-1201-1215

Kansas Department of Health and Environment-Division of Environment
(Water well Contractors)
Topeka, Kansas 66620

1. Location of well: County Dickinson Fraction NW 1/4 NE 1/4 NE 1/4 Section number 8 Township number T 14 S R 2 Range number EW

2. Distance and direction from nearest town or city: 4 miles south of Abilene Street address of well location if in city: _____
3. Owner of well: Lyle Hoffman R.R. or street: R.R. # 2 City, state, zip code: Abilene, Kansas

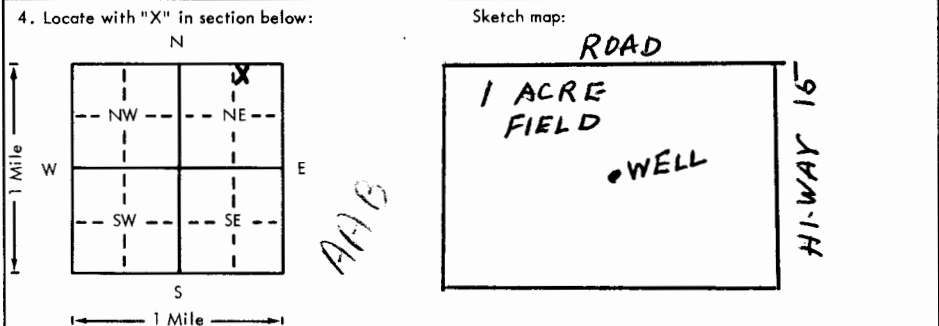

6. Bore hole dia. 8 in. Completion date _____
Well depth 79 ft. 10/3/77
7. Cable tool Rotary Driven Dug
 Hollow rod Jetted Bored Reverse rotary
8. Use: Domestic Public supply Industry
 Irrigation Air conditioning Stock
 Lawn Oil field water Other
9. Casing: Material plst Height: Above or below
Threaded Welded gl Surface 18 in.
RMP PVC Weight _____ lbs./ft.
Dia. 5 in. to 79 ft. depth Wall Thickness: inches or
Dia. _____ in. to _____ ft. depth gage No. 0.258

5. Type and color of material	From	To
Black top soil	0	1
Brown clay	1	8
Yellow clay and shale	8	60
Yellow shale and rock	60	68
Blue clay and shale	68	79
(Use a second sheet if needed)		

10. Screen: Manufacturer's name western Plastics
Type RMP Dia. 5"
Slot/gauze 3/32 Length 40
Set between 39 ft. and 79 ft.
_____ ft. and _____ ft.
Gravel pack? Yes Size range of material 1/16 to 3/8
11. Static water level: _____ mo./day/yr.
53 ft. below land surface Date 10/3/77
12. Pumping level below land surfaces:
_____ ft. after _____ hrs. pumping _____ g.p.m.
_____ ft. after _____ hrs. pumping _____ g.p.m.
Estimated maximum yield 10+ g.p.m.
13. Water sample submitted: _____ mo./day/yr.
 Yes No Date _____
14. Well head completion: _____
 Pitless adapter 18 Inches above grade
15. Well grouted? Yes
With: Neat cement Bentonite Concrete
Depth: From 0 ft. to 10 ft.
16. Nearest source of possible contamination:
ft. 150' Direction SW Type Septic
Well disinfected upon completion? Yes No
17. Pump: Not installed
Manufacturer's name _____
Model number _____ HP _____ Volts _____
Length of drop pipe _____ ft. capacity _____ g.p.m.
Type:
 Submersible Turbine
 Jet Reciprocating
 Centrifugal Other

18. Elevation: _____
19. Remarks: _____
Topography:
 Hill
 Slope
 Upland
 Valley

20. Water well contractor's certification:
This well was drilled under my jurisdiction and this report is true to the best of my knowledge and belief.
Rader Drilling Co. 194
Business name License No. _____
Address Carlton, Kansas 67429
Signed Brent E. Rader Date 1-9-78
Authorized representative

T 14
R 2
S 8
Sec
1/4 1/4 NE
PLINE NE