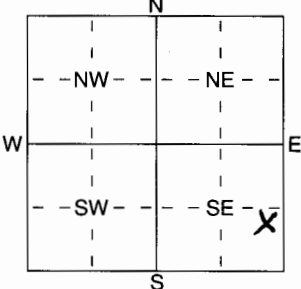


1 LOCATION OF WATER WELL: Fraction Section Number Township Number Range Number  
 County: DECKLISON NB 1/4 SE 1/4 SE 1/4 11 T 14 S R 2 EW

Distance and direction from nearest town or city street address of well if located within city?

FROM FENTRIPRESS: 4 MILES SOUTH AND 3 WEST AND 1/4 NORTH ON JEEP RD.

2 WATER WELL OWNER: MARK McLELLAN  
 RR#, St. Address, Box # : 1691 JEEP RD. Board of Agriculture, Division of Water Resources  
 City, State, ZIP Code : ABILENE, KS 67410 Application Number: \_\_\_\_\_

3 LOCATE WELL'S LOCATION WITH AN "X" IN SECTION BOX:  4 DEPTH OF COMPLETED WELL 182 ft. ELEVATION: \_\_\_\_\_  
 Depth(s) Groundwater Encountered 1 83 ft. 2 \_\_\_\_\_ ft. 3 \_\_\_\_\_ ft.  
 WELL'S STATIC WATER LEVEL \_\_\_\_\_ ft. below land surface measured on mo/day/yr \_\_\_\_\_  
 Pump test data: Well water was \_\_\_\_\_ ft. after \_\_\_\_\_ hours pumping \_\_\_\_\_ gpm  
 Est. Yield 30 gpm: Well water was \_\_\_\_\_ ft. after \_\_\_\_\_ hours pumping \_\_\_\_\_ gpm  
 WELL WATER TO BE USED AS: 5 Public water supply 8 Air conditioning 11 Injection well  
 1 Domestic 3 Feedlot 6 Oil field water supply 9 Dewatering 12 Other (Specify below)  
 2 Irrigation 4 Industrial 7 Domestic (lawn & garden) 10 Monitoring well CLOSED LUMP GROUTING  
 Was a chemical/bacteriological sample submitted to Department? Yes \_\_\_\_\_ No X; If yes, mo/day/yr sample was submitted  
 Water Well Disinfected? Yes \_\_\_\_\_ No X

5 TYPE OF BLANK CASING USED: 5 Wrought iron 8 Concrete tile CASING JOINTS: Glued \_\_\_\_\_ Clamped \_\_\_\_\_  
 1 Steel 3 RMP (SR) 6 Asbestos-Cement 9 Other (specify below) Welded X  
 2 PVC 4 ABS 7 Fiberglass Threaded \_\_\_\_\_  
 Blank casing diameter 3 1/4 in. to 182 ft., Dia \_\_\_\_\_ in. to \_\_\_\_\_ ft., Dia \_\_\_\_\_ in. to \_\_\_\_\_ ft.  
 Casing height below land surface 12 in., weight \_\_\_\_\_ lbs./ft. Wall thickness or gauge No. 50R11  
 TYPE OF SCREEN OR PERFORATION MATERIAL: 7 PVC 10 Asbestos-Cement  
 1 Steel 3 Stainless Steel 5 Fiberglass 8 RMP (SR) 11 Other (Specify) \_\_\_\_\_  
 2 Brass 4 Galvanized Steel 6 Concrete tile 9 ABS 12 None used (open hole)  
 SCREEN OR PERFORATION OPENINGS ARE: 5 Gauzed wrapped 8 Saw cut 11 None (open hole)  
 1 Continuous slot 3 Mill slot 6 Wire wrapped 9 Drilled holes  
 2 Louvered shutter 4 Key punched 7 Torch cut 10 Other (specify) \_\_\_\_\_ ft.  
 SCREEN-PERFORATED INTERVALS: From \_\_\_\_\_ ft. to \_\_\_\_\_ ft., From \_\_\_\_\_ ft. to \_\_\_\_\_ ft.  
 From \_\_\_\_\_ ft. to \_\_\_\_\_ ft., From \_\_\_\_\_ ft. to \_\_\_\_\_ ft.  
 GRAVEL PACK INTERVALS: From \_\_\_\_\_ ft. to \_\_\_\_\_ ft., From \_\_\_\_\_ ft. to \_\_\_\_\_ ft.  
 From \_\_\_\_\_ ft. to \_\_\_\_\_ ft., From \_\_\_\_\_ ft. to \_\_\_\_\_ ft.

6 GROUT MATERIAL: 1 Neat cement 2 Cement grout 3 Bentonite 4 Other \_\_\_\_\_  
 Grout Intervals: From 1 ft. to 182 ft., From \_\_\_\_\_ ft. to \_\_\_\_\_ ft., From \_\_\_\_\_ ft. to \_\_\_\_\_ ft.  
 What is the nearest source of possible contamination: 10 Livestock pens 14 Abandoned water well  
 1 Septic tank 4 Lateral lines 7 Pit privy 11 Fuel storage 15 Oil well/Gas well  
 2 Sewer lines 5 Cess pool 8 Sewage lagoon 12 Fertilizer storage 16 Other (specify below)  
 3 Watertight sewer lines 6 Seepage pit 9 Feedyard 13 Insecticide storage BELOW BASEMENT FLOOR  
 Direction from well? \_\_\_\_\_ How many feet? \_\_\_\_\_

FROM	TO	LITHOLOGIC LOG	FROM	TO	PLUGGING INTERVALS
0	72	SHALE TAN			
72	73	GYPSUM			1 HOLE TO 182
73	78	LIME STONE			1 HOLE TO 173
78	83	LIMESTONE LOOSE H <sub>2</sub> O			1 HOLE TO 164
83	98	SHALE, GRAY			1 HOLE TO 160
98	104	LIME STONE, GRAY			1 HOLE TO 172
104	112	SHALE, RED			1 HOLE TO 180
112	126	SHALE, GRAY			
126	130	LIME STONE			
130	151	SHALE, GRAY w/ GYPSUM			
151	157	LIME STONE			
157	182	SHALE GRAY			

7 CONTRACTOR'S OR LANDOWNER'S CERTIFICATION: This geothermal well was (1) constructed, (2) reconstructed, or (3) plugged under my jurisdiction and was completed on (mo/day/year) 8/25/05 and this record is true to the best of my knowledge and belief. Kansas Water Well Contractor's Licence No 76V This Water Well Record was completed on (mo/day/yr) 9/23/05 under the business name of ASSOCIATED DRILLING INC. by (signature) [Signature]