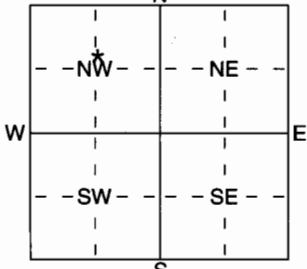


1 LOCATION OF WATER WELL: Fraction SW 1/4 NE 1/4 NW 1/4 Section Number 4 Township Number T 14 S Range Number R 2 E 1/4
 County: Dickinson

Distance and direction from nearest town or city street address of well if located within city?
2 1/2 miles South of Abilene, Ks on Hwy 15 at 934-1890 Dr

2 WATER WELL OWNER: Steve Keim
 RR#, St. Address, Box # : 934 - 1890 Dr Board of Agriculture, Division of Water Resources
 City, State, ZIP Code : Abilene, Kansas 67410 Application Number:

3 LOCATE WELL'S LOCATION WITH AN "X" IN SECTION BOX:  DEPTH OF COMPLETED WELL 9.3 ft. ELEVATION:
 Depth(s) Groundwater Encountered 1 5.4 ft. 2 ft. 3 ft.
 WELL'S STATIC WATER LEVEL 4.7 ft. below land surface measured on 11 / 22 / 05
 Pump test data: Well water was ft. after hours pumping gpm
 Est. Yield 7 3/4 gpm: Well water was ft. after hours pumping gpm
 WELL WATER TO BE USED AS: 5 Public water supply 8 Air conditioning 11 Injection well
1 Domestic 3 Feedlot 6 Oil field water supply 9 Dewatering 12 Other (Specify below)
2 Irrigation 4 Industrial 7 Domestic (lawn & garden) 10 Monitoring well
 Was a chemical/bacteriological sample submitted to Department? Yes No*
 Water Well Disinfected? Yes * No

5 TYPE OF BLANK CASING USED: 1 Steel 3 RMP (SR) 5 Wrought iron 8 Concrete tile CASING JOINTS: Glued* Clamped
 2 PVC 4 ABS 6 Asbestos-Cement 9 Other (specify below) Welded
 7 Fiberglass Threaded
 Blank casing diameter 5 in. to 9.3 ft., Dia in. to ft., Dia in. to ft.
 Casing height above land surface 1.6 in., weight 2.00 lbs./ft. Wall thickness or guage No. 2.50
 TYPE OF SCREEN OR PERFORATION MATERIAL: 7 PVC 10 Asbestos-Cement
 1 Steel 3 Stainless Steel 5 Fiberglass 8 RMP (SR) 11 Other (Specify)
 2 Brass 4 Galvanized Steel 6 Concrete tile 9 ABS 12 None used (open hole)
 SCREEN OR PERFORATION OPENINGS ARE: 5 Guazed wrapped 8 Saw cut 11 None (open hole)
 1 Continuous slot 3 Mill slot 6 Wire wrapped 9 Drilled holes
 2 Louvered shutter 4 Key punched 7 Torch cut 10 Other (specify) ft.
 SCREEN-PERFORATED INTERVALS: From 5.3 ft. to 9.3 ft., From ft. to ft.
 From ft. to ft., From ft. to ft.
 GRAVEL PACK INTERVALS: From 2.3 ft. to 9.3 ft., From ft. to ft.
 From ft. to ft., From ft. to ft.

6 GROUT MATERIAL: 1 Neat cement 2 Cement grout 3 Bentonite 4 Other
 Grout Intervals: From 3 ft. to 2.3 ft., From ft. to ft., From ft. to ft.
 What is the nearest source of possible contamination: 10 Livestock pens 14 Abandoned water well
1 Septic tank 4 Lateral lines 7 Pit privy 11 Fuel storage 15 Oil well/Gas well
 2 Sewer lines 5 Cess pool 8 Sewage lagoon 12 Fertilizer storage 16 Other (specify below)
 3 Watertight sewer lines 6 Seepage pit 9 Feedyard 13 Insecticide storage

Direction from well? NORTHWEST APPROX How many feet? 200+

FROM	TO	LITHOLOGIC LOG	FROM	TO	PLUGGING INTERVALS
0	1	DARK TOP SOIL			
1	6	LITE COLOR SHALE & CLAY			
6	9	LITE COLOR LIMESTONE			
9	57	LITE COLOR CLAY & SHALE			
57	62	RED & MAROON CLAY & SHALE			
62	72	GRAY SOFT CLAY			
72	75	RED & MAROON CLAY			
75	81	LITE GRAY CLAY			
81	85	BLUE CLAY			
85	93	GYP SUM ROCK			

7 CONTRACTOR'S OR LANDOWNER'S CERTIFICATION: This water well was (1) constructed, (2) reconstructed, or (3) plugged under my jurisdiction and was completed on (mo/day/year) 1.1 / 22 / 05 and this record is true to the best of my knowledge and belief. Kansas Water Well Contractor's Licence No 397 This Water Well Record was completed on (mo/day/yr) 11 / 29 / 05 under the business name of CENTRAL KANSAS DRILLING by (signature) David D. Martin