

WATER WELL RECORD


Form WWC-5

Division of Water Resources App. No.

1 LOCATION OF WATER WELL: County: Dickinson Fraction: 1/4 SE 1/4 SE 1/4 NE 1/4 Section Number: 27 Township No. T 14 S Range Number R 2

Street/Rural Address of Well Location; if unknown, distance & direction from nearest town or intersection: If at owner's address, check here. Global Positioning System (GPS) information: Latitude: Longitude: Elevation: Datum: Collection Method: Est. Accuracy:

2 WATER WELL OWNER: Gene Hoffman RR#, Street Address, Box #: 516 E. 15th St. City, State, ZIP Code: Abilene, KS 67410

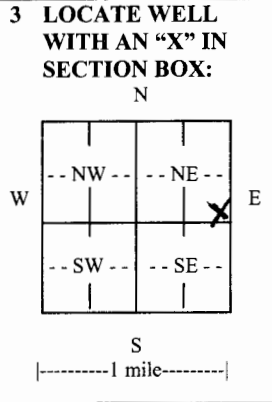

3 LOCATE WELL WITH AN 'X' IN SECTION BOX: 4 DEPTH OF COMPLETED WELL: Depth(s) Groundwater Encountered (1) 55 ft. (2) ft. (3) ft. WELL'S STATIC WATER LEVEL 28 ft. below land surface measured on mo/day/yr 9-14-12. Pump test data: Well water was... EST. YIELD 20 gpm. Bore Hole Diameter... WELL WATER TO BE USED AS: [X] Domestic-lawn & garden. Was a chemical/bacteriological sample submitted to Department? [X] No. Water well disinfected? [X] Yes

5 TYPE OF CASING USED: [X] PVC CASING JOINTS: [X] Glued Casing diameter 5 in. to 67 ft. Casing height above land surface 14 in. Weight SDR 26 lbs./ft. Wall thickness or gauge No. 219 TYPE OF SCREEN OR PERFORATION MATERIAL: [X] PVC SCREEN OR PERFORATION OPENINGS ARE: [X] Saw cut SCREEN-PERFORATED INTERVALS: From 45 ft. to 67 ft. GRAVEL PACK INTERVALS: From 20 ft. to 67 ft.

6 GROUT MATERIAL: Neat cement, Cement grout, Bentonite, Other Grout Intervals: From 0 ft. to 20 ft. What is the nearest source of possible contamination: [X] Fuel storage Direction from well SW Distance from well 75

Table with 6 columns: FROM, TO, LITHOLOGIC LOG, FROM, TO, LITHO. LOG (cont.) or PLUGGING INTERVALS. Rows include: 0-3 Top Soil, 3-30 yellow Clay + Shale, 30-55 Blue Shale, 55-56 Crumbled Shale + Water, 56-67 Gray Shale

7 CONTRACTOR'S OR LANDOWNER'S CERTIFICATION: This water well was [X] constructed, [] reconstructed, or [] plugged under my jurisdiction and was completed on (mo/day/year) 9-14-12 and this record is true to the best of my knowledge and belief. Kansas Water Well Contractor's License No. 180 This Water Well Record was completed on (mo/day/year) 9-13-12 under the business name of Backhoe Drilling by (signature) Paul H. Pauline

INSTRUCTIONS: Use typewriter or ball point pen. PLEASE PRESS FIRMLY and PRINT clearly. Please fill in blanks and check the correct answers. Send three copies (white, blue, pink) to Kansas Department of Health and Environment, Bureau of Water, Geology Section, 1000 SW Jackson St., Suite 420, Topeka, Kansas 66612-1367. Telephone 785-296-5524. Send one copy to WATER WELL OWNER and retain one for your records. Include fee of \$5.00 for each constructed well. Visit us at http://www.kdheks.gov/waterwell/index.html.