


1 LOCATION OF WATER WELL: County: Douglas Fraction: NW 1/4 NW 1/4 SE 1/4 Section Number: 8 Township Number: T 14 S Range Number: R 20 E1W

Distance and direction from nearest town or city street address of well if located within city?
746 E 1550 Rd Baldwin City, KS.

2 WATER WELL OWNER: Chris Haley 4-160 Bares
 RR#, St. Address, Box #: 887 East 808 Rd Board of Agriculture, Division of Water Resource:
 City, State, ZIP Code: Lawrence, KS, 66047 Application Number:

3 LOCATE WELL'S LOCATION WITH AN "X" IN SECTION BOX: 4 DEPTH OF COMPLETED WELL 160 ft. ELEVATION:

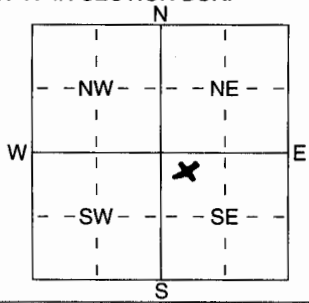

Depth(s) Groundwater Encountered 1 None ft. 2 ft. 3 ft.
 WELL'S STATIC WATER LEVEL None ft. below land surface measured on mo/day/yr
 Pump test data: Well water was ft. after hours pumping gpm
 Est. Yield None gpm: Well water was ft. after hours pumping gpm
 WELL WATER TO BE USED AS:
 1 Domestic 3 Feedlot 6 Oil field water supply 9 Dewatering 12 Other (Specify below)
 2 Irrigation 4 Industrial 7 Domestic (lawn & garden) 10 Monitoring well

Was a chemical/bacteriological sample submitted to Department? Yes No X; If yes, mo/day/yr sample was submitted
 Water Well Disinfected? Yes No X

5 TYPE OF BLANK CASING USED:
 1 Steel 3 RMP (SR) 5 Wrought iron 8 Concrete tile CASING JOINTS: Glued Clamped
 2 PVC 4 ABS 6 Asbestos-Cement 9 Other (specify below) Welded Fusion
H.D. Polyethylene Threaded

Blank casing diameter below 3/4 in. to 160 ft. Dia in. to ft.
 Casing height above land surface 36"-40" in. weight SDR 11 160 PSI lbs./ft. Wall thickness or gauge No.

TYPE OF SCREEN OR PERFORATION MATERIAL: None
 1 Steel 3 Stainless Steel 5 Fiberglass 7 PVC 10 Asbestos-Cement
 2 Brass 4 Galvanized Steel 6 Concrete tile 9 ABS 11 Other (Specify)

SCREEN OR PERFORATION OPENINGS ARE: None
 1 Continuous slot 3 Mill slot 5 Guazed wrapped 8 Saw cut 11 None (open hole)
 2 Louvered shutter 4 Key punched 6 Wire wrapped 9 Drilled holes
 7 Torch cut 10 Other (specify)

SCREEN-PERFORATED INTERVALS: From ft. to ft., From ft. to ft.
 GRAVEL PACK INTERVALS: From ft. to ft., From ft. to ft.

6 GROUT MATERIAL: 1 Neat cement 2 Cement grout 3 Bentonite 4 Other
 Grout Intervals: From 160 ft. to 3 ft., From ft. to ft., From ft. to ft.

What is the nearest source of possible contamination: None at the time of drilling
 1 Septic tank 4 Lateral lines 7 Pit privy drilling 10 Livestock pens 14 Abandoned water well
 2 Sewer lines 5 Cess pool 8 Sewage lagoon 11 Fuel storage 15 Oil well/Gas well
 3 Watertight sewer lines 6 Seepage pit 9 Feedyard 12 Fertilizer storage 16 Other (specify below)
 13 Insecticide storage

FROM	TO	LITHOLOGIC LOG	FROM	TO	PLUGGING INTERVALS
0	16	yellow sandstone			
16	39	grey sandstone			
39	120	shale			
120	146	Limestone			
146	160	Shale			

7 CONTRACTOR'S OR LANDOWNER'S CERTIFICATION: This water well was (1) constructed, (2) reconstructed, or (3) plugged under my jurisdiction and was completed on (mo/day/year) 7-26-04 and this record is true to the best of my knowledge and belief. Kansas Water Well Contractor's Licence No 561 This Water Well Record was completed on (mo/day/yr) 7-27-04 under the business name of Evans Energy Dev. Inc. by (signature) Scott G. Evans