


1	LOCATION OF WATER WELL:	Fraction SE 1/4 SE 1/4 1/4	Section Number 15	Township Number 14	Range Number 20 E/W
---	-------------------------	--------------------------------------	-----------------------------	------------------------------	-------------------------------

Distance and direction from nearest town or city street address of well if located within city?

2	WATER WELL OWNER: Floyd Schmidt	RR #, St. Address, Box #: 1273 N. 600 Rd.	Board of Agriculture, Division of Water Resources
	City, State, ZIP Code: Baldwin City, KS 66006	Application Number:	

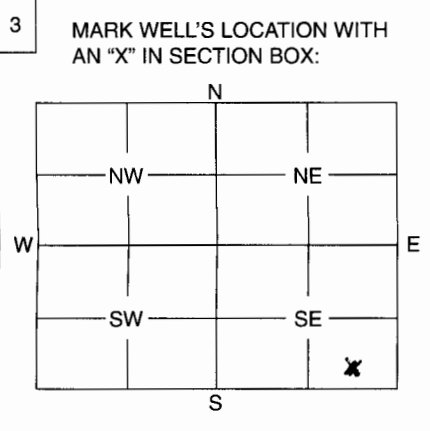

4	DEPTH OF WELL 17.5 ft.	WELL'S STATIC WATER LEVEL 14.5 ft.
	WELL WAS USED AS:	
	<input checked="" type="radio"/> 1 Domestic <input type="radio"/> 2 Irrigation <input type="radio"/> 3 Feedlot <input type="radio"/> 4 Industrial	<input type="radio"/> 5 Public Water Supply <input type="radio"/> 6 Oil Field Water Supply <input type="radio"/> 7 Domestic (Lawn & Garden) <input type="radio"/> 8 Air Conditioning
		<input type="radio"/> 9 Dewatering <input type="radio"/> 10 Monitoring Well <input type="radio"/> 11 Injection Well <input type="radio"/> 12 Other
	Was a chemical / bacteriological sample submitted to Department? Yes No <input checked="" type="checkbox"/>	
	If yes, mo/day/yr sample was submitted	
	Water Well Disinfected: Yes <input checked="" type="checkbox"/> No	

5	TYPE OF BLANK CASING USED:				
	1 Steel	3 RMP (SR)	5 Wrought	7 Fiberglass	9 Other (Specify below)
	2 PVC	4 ABS	6 Asbestos-Cement	8 Concrete Tile	Rock lining
	Blank casing diameter in.		Was casing pulled? Yes No		If yes, how much
	Casing height above or below land surface in.				

6	GROUT PLUG MATERIAL:	1 Neat cement	2 Cement grout	<input checked="" type="radio"/> 3 Bentonite	4 Other
	Grout Plug Intervals:	From 5 ft. to 4.5 ft.,	From ft. to ft.,	From ft. to ft.,	From to ft.
	What is the nearest source of possible contamination:				
	<input checked="" type="radio"/> 1 Septic tank <input type="radio"/> 2 Sewer lines <input type="radio"/> 3 Watertight sewer lines <input type="radio"/> 4 Lateral lines <input type="radio"/> 5 Cess pool	<input type="radio"/> 6 Seepage pit <input type="radio"/> 7 Pit privy <input type="radio"/> 8 Sewage lagoon <input type="radio"/> 9 Feedyard <input type="radio"/> 10 Livestock pens	<input type="radio"/> 11 Fuel storage <input type="radio"/> 12 Fertilizer storage <input type="radio"/> 13 Insecticide storage <input type="radio"/> 14 Abandoned water well <input type="radio"/> 15 Oil well/Gas well	<input type="radio"/> 16 Other (specify below)	
	Direction from well? WNW		How many feet? 100 yds		

FROM	TO	PLUGGING MATERIALS
17.5	10	Rock lining
10	5	Sand
5	4.5	Bentonite
4.5	TOP	Top soil

7	CONTRACTOR'S OF LANDOWNER'S CERTIFICATION: This water well was plugged under my jurisdiction and was completed on (mo/day/year) 5/18/07 and this record is true to the best of my knowledge and belief. Kansas Water Well Contractor's License No. This Water Well Record was completed on (mo/day/year)	
	by (signature) Floyd R. Schmidt under the business name of	

INSTRUCTIONS: Use typewriter or ball point pen. Please press firmly and print clearly. Please fill in blanks, underline or circle the correct answers. Send top three copies to Kansas Department of Health and Environment, Bureau of Water, Geology Section, 1000 SW Jackson St., Ste. 420, Topeka, Kansas 66612-1367. Telephone: 785/296-5522. Send one to Water Well Owner and retain one for your records.