

(Per KDHE)

WATER WELL PLUGGING RECORD Form WWC-5P

KSA 82a-1212

ID NO.

[Empty box for ID number]


1	LOCATION OF WATER WELL: County: Douglas	Fraction $\frac{1}{4}$ N $\frac{1}{2}$ $\frac{1}{4}$ NW $\frac{1}{4}$	Section Number 15	Township Number T 14 S	Range Number 20 <input checked="" type="checkbox"/> E <input type="checkbox"/> W
---	--	--	----------------------	---------------------------	---

Street/Rural Address of Well Location; if unknown, distance & direction from nearest town or intersection: If at owner's address, check here 60' north of N0692 Rd and 31' east of E1725 Rd., Baldwin City, Kansas

Global Positioning Systems (GPS) information:
 Latitude: N38.839517 (in decimal degrees)
 Longitude: W95.181683 (in decimal degrees)
 Elevation: _____
 Horizontal Datum: WGS84, NAD83, NAD27
 Collection Method: _____

2 WATER WELL OWNER: Douglas County ROW
 RR#, St. Address, Box #: _____
 City, State ZIP Code: _____

GPS unit (Make/Model): _____
 Digital Map/Photo, Topographic Map, Land Survey
 Est. Accuracy: < 3 m, 3-5 m, 5-15 m, > 15 m

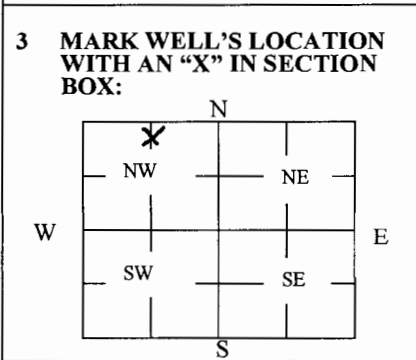

4 DEPTH OF WELL 10'-2" ft.
 WELL'S STATIC WATER LEVEL 8'-10" ft

WELL WAS USED AS:

<input checked="" type="checkbox"/> Domestic	<input type="checkbox"/> Public Water Supply	<input type="checkbox"/> Dewatering
<input type="checkbox"/> Irrigation	<input type="checkbox"/> Oil Field Water Supply	<input type="checkbox"/> Monitoring
<input type="checkbox"/> Feedlot	<input type="checkbox"/> Domestic (Lawn & Garden)	<input type="checkbox"/> Injection Well
<input type="checkbox"/> Industrial	<input type="checkbox"/> Air Conditioning	<input type="checkbox"/> Other _____

Was a chemical/bacteriological sample submitted to Department? Yes No

5 TYPE OF BLANK CASING USED:

<input type="checkbox"/> Steel	<input type="checkbox"/> RMP (SR)	<input type="checkbox"/> Wrought	<input type="checkbox"/> Fiberglass	<input checked="" type="checkbox"/> Other (Specify below)
<input type="checkbox"/> PVC	<input type="checkbox"/> ABS	<input type="checkbox"/> Asbestos-Cement	<input type="checkbox"/> Concrete Tile	<u>Limestone</u>

Blank casing diameter 30" in. Was casing pulled? Yes No If yes, how much 0' to 6'-6"
 Casing height above or below land surface 6'-6" in.

6 GROUT PLUG MATERIAL: Neat cement Cement grout Bentonite Other Bagged Concrete

Grout Plug Intervals: From 6'-0" ft. to 8'-10" ft., From _____ ft. to _____ ft., From _____ ft. to _____ ft.

What is the nearest source of possible contamination:

<input type="checkbox"/> Septic tank	<input type="checkbox"/> Seepage pit	<input type="checkbox"/> Fuel storage	<input type="checkbox"/> Other (specify below)
<input type="checkbox"/> Sewer lines	<input type="checkbox"/> Pit privy	<input type="checkbox"/> Fertilizer storage	_____
<input type="checkbox"/> Watertight sewer lines	<input type="checkbox"/> Sewage lagoon	<input type="checkbox"/> Insecticide storage	_____
<input type="checkbox"/> Lateral lines	<input type="checkbox"/> Feedyard	<input type="checkbox"/> Abandoned water well	Direction from well? _____
<input type="checkbox"/> Cess pool	<input type="checkbox"/> Livestock pens	<input type="checkbox"/> Oil well/Gas well	How many feet? _____

FROM	TO	PLUGGING MATERIALS	FROM	TO	PLUGGING MATERIALS
10'-2"	8'-10"	Chlorinated sand			
8'-10"	6'-0"	Concrete Cap			
6'-0"	1'-0"	Compacted clay			
1'-0"	0"	Topsoil			

7 CONTRACTOR'S OR LANDOWNER'S CERTIFICATION: This water well was plugged under my jurisdiction and was completed on (mo/day/year) April 4, 2019 and this record is true to the best of my knowledge and belief. Kansas Water Well Contractor's License No. _____. This Water Well Record was completed on (mo/day/year) April 4, 2019 under the business name of Douglas County by (signature) Doug Stephens *Doug Stephens*

Send one white copy to Kansas Department of Health & Environment, Geology Section, 1000 SW Jackson Street, Ste. 420, Topeka, KS 66612-1367. Send one copy to WATER WELL OWNER and retain one for your records.
 Visit us at <http://www.kdheks.gov/waterwell/index.html> Telephone 785-296-5524.