


WATER WELL PLUGGING RECORD Form WWC-5P KSA 82a-1212 ID NO.

MW-5

1 LOCATION OF WATER WELL: Fraction NW ¼ SW ¼ SW ¼ SW ¼ Section Number 34 Township Number T 14 S Range Number 20 E W
 County: Douglas
 Street/Rural Address of Well Location; if unknown, distance & direction from nearest town or intersection: If at owner's address, check here 522 Ames, Baldwin City
Global Positioning Systems (GPS) information:
 Latitude: 38.78339N (in decimal degrees)
 Longitude: 95.18564W (in decimal degrees)
 Elevation: 1052.87
 Horizontal Datum: WGS84, NAD83, NAD27
 Collection Method:

2 WATER WELL OWNER: Prairieburg, L.L.C.
 RR#, St. Address, Box #: 1654 N. 400 Road
 City, State ZIP Code: Baldwin City, KS 66006
 GPS unit (Make/Model: _____)
 Digital Map/Photo, Topographic Map, Land Survey
 Est. Accuracy: < 3 m, 3-5 m, 5-15 m, > 15 m

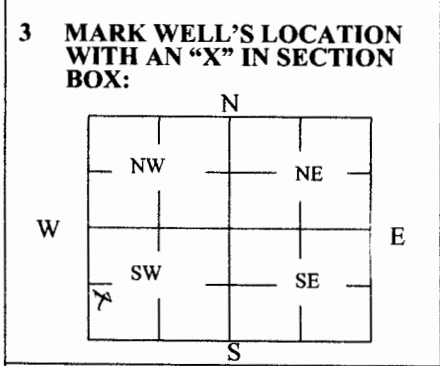

4 DEPTH OF WELL 11.91 **ft.**
 WELL'S STATIC WATER LEVEL 9.82 **ft.**
 WELL WAS USED AS:
 Domestic Public Water Supply Dewatering
 Irrigation Oil Field Water Supply Monitoring
 Feedlot Domestic (Lawn & Garden) Injection Well
 Industrial Air Conditioning Other _____
 Was a chemical/bacteriological sample submitted to Department? Yes No

5 TYPE OF BLANK CASING USED:
 Steel RMP (SR) Wrought Fiberglass Other (Specify below) _____
 PVC ABS Asbestos-Cement Concrete Tile
 Blank casing diameter 2 in. Was casing pulled? Yes No If yes, how much 3.5 ft
 Casing height above or below land surface -0.39 ft in.

6 GROUT PLUG MATERIAL: Neat cement Cement grout Bentonite Other _____
 Grout Plug Intervals: From 11.91 ft. to 3 ft., From _____ ft. to _____ ft., From _____ ft. to _____ ft.
 What is the nearest source of possible contamination:
 Septic tank Seepage pit Fuel storage Other (specify below) _____
 Sewer lines Pit privy Fertilizer storage
 Watertight sewer lines Sewage lagoon Insecticide storage
 Lateral lines Feedyard Abandoned water well Direction from well? Southeast
 Cess pool Livestock pens Oil well/Gas well How many feet? 90

FROM	TO	PLUGGING MATERIALS	FROM	TO	PLUGGING MATERIALS
11.91	3.00	Hydrated Bentonite			
3.00	0.08	Bag Topsoil			
0.08	Grade	Turf			

7 CONTRACTOR'S OR LANDOWNER'S CERTIFICATION: This water well was plugged under my jurisdiction and was completed on (mo/day/year) 11/26/19 and this record is true to the best of my knowledge and belief. Kansas Water Well Contractor's License No. 337 LG. This Water Well Record was completed on (mo/day/year) 12/1/19 under the business name of Knightly Environmental Inc. by (signature) John Paul Knightly

Send one white copy to Kansas Department of Health & Environment, Geology Section, 1000 SW Jackson Street, Ste. 420, Topeka, KS 66612-1367. Send one copy to WATER WELL OWNER and retain one for your records.
 Visit us at <http://www.kdhcks.gov/waterwell/index.html> Telephone 785-296-5524.