

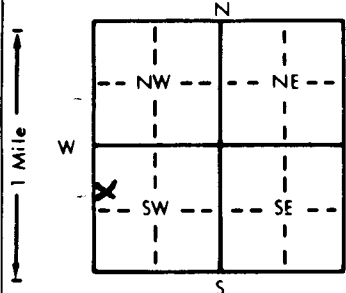
1 LOCATION OF WATER WELL:	Fraction	Section Number	Township Number	Range Number
County: <u>Douglas</u>	<u>SW</u> $\frac{1}{4}$ <u>NW</u> $\frac{1}{4}$ <u>SW</u> $\frac{1}{4}$	<u>7</u>	T <u>14</u> S	R <u>21</u> <u>EW</u>

Distance and direction from nearest town or city street address of well if located within city?

5.63 South + 2 West of Endora, KS.

2 WATER WELL OWNER: <u>Craig + Terry Bridgens</u>	<u>Douglas Cty Permit # 24037</u>
RR#, St. Address, Box #: <u>734 E 2000 Rd.</u>	Board of Agriculture, Division of Water Resources
City, State, ZIP Code: <u>Endora, KS, 66025</u>	Application Number:

3 LOCATE WELL'S LOCATION WITH AN "X" IN SECTION BOX:	4 DEPTH OF COMPLETED WELL: <u>150</u> ft. ELEVATION:
--	--

Depth(s) Groundwater Encountered 1. NONE ft. 2. ft. 3. ft.WELL'S STATIC WATER LEVEL NDAE ft. below land surface measured on mo/day/yr

Pump test data: Well water was ft. after hours pumping gpm

Est. Yield 0 gpm; Well water was ft. after hours pumping gpmBore Hole Diameter 5 1/8 in. to 150 ft., and in. to ft.

WELL WATER TO BE USED AS: 5 Public water supply 8 Air conditioning 11 Injection well

6 Domestic 3 Feedlot 6 Oil field water supply 9 Dewatering 12 Other (Specify below)

2 Irrigation 4 Industrial 7 Lawn and garden only 10 Monitoring well

Was a chemical/bacteriological sample submitted to Department? Yes No X; If yes, mo/day/yr sample was submittedWater Well Disinfected? Yes No X

5 TYPE OF BLANK CASING USED:	5 Wrought iron	8 Concrete tile	CASING JOINTS: Glued Clamped
1 Steel	3 RMP (SR)	9 Other (specify below)	Welded
<u>2</u> PVC	<u>4</u> ABS		Threaded

Blank casing diameter 4 in. to ft., Dia in. to ft., Dia in. to ft.Casing height above land surface 0 in., weight lbs./ft. Wall thickness or gauge No.

TYPE OF SCREEN OR PERFORATION MATERIAL: 7 PVC 10 Asbestos-cement

1 Steel 3 Stainless steel 5 Fiberglass 8 RMP (SR) 11 Other (specify) NA

2 Brass 4 Galvanized steel 6 Concrete tile 9 ABS 12 None used (open hole)

SCREEN OR PERFORATION OPENINGS ARE: 5 Gauzed wrapped 8 Saw cut 11 None (open hole)

1 Continuous slot 3 Mill slot 6 Wire wrapped 9 Drilled holes

2 Louvered shutter 4 Key punched 7 Torch cut 10 Other (specify) NASCREEN-PERFORATED INTERVALS: From 999 ft. to 999 ft., From ft. to ft.

From ft. to ft., From ft. to ft.

GRAVEL PACK INTERVALS: From ft. to ft., From ft. to ft.

From ft. to ft., From ft. to ft.

6 GROUT MATERIAL:	1 Neat cement	2 Cement grout	<u>3</u> Bentonite	4 Other
-------------------	---------------	----------------	--------------------	---------

Grout Intervals: From 150 ft. to 0 ft., From ft. to ft., From ft. to ft.

What is the nearest source of possible contamination: 10 Livestock pens 14 Abandoned water well

1 Septic tank 4 Lateral lines 7 Pit privy 11 Fuel storage 15 Oil well/Gas well

2 Sewer lines 5 Cess pool 8 Sewage lagoon 12 Fertilizer storage 16 Other (specify below)

3 Watertight sewer lines 6 Seepage pit 9 Feedyard 13 Insecticide storage

Direction from well? How many feet?

FROM	TO	LITHOLOGIC LOG	FROM	TO	PLUGGING INTERVALS
<u>0</u>	<u>5</u>	<u>Soil + clay</u>	<u>150</u>	<u>0</u>	<u>High Solids Bentonite</u>
<u>5</u>	<u>125</u>	<u>Shale</u>			
<u>125</u>	<u>130</u>	<u>Limestone</u>			
<u>136</u>	<u>134</u>	<u>Fine gray sandstone</u>			
<u>134</u>	<u>150</u>	<u>Limestone</u>			

7 CONTRACTOR'S OR LANDOWNER'S CERTIFICATION: This water well was (1) constructed, (2) reconstructed, or <u>(3)</u> plugged under my jurisdiction and was completed on (mo/day/year) <u>11-17-98</u> and this record is true to the best of my knowledge and belief Kansas
Water Well Contractor's License No. <u>561</u> This Water Well Record was completed on (mo/day/yr) <u>11-18-98</u>
under the business name of <u>EVANS Energy Dev. Inc.</u> by (signature) <u>Scott H. Evans</u>