

CORRECTION(S) TO WATER WELL RECORD (WWC-5)

(to rectify lacking or incorrect information)

County: Douglas

Location listed as:

Section-Township-Range: 27-14-21

Fraction ($\frac{1}{4}$ $\frac{1}{4}$ $\frac{1}{4}$): SW NE NW

Location changed to:

27-14S-21E

C SE NW

Other changes: Initial statements: _____

Changed to: _____

Comments: _____


verification method: Personal communication from well owner, and mapping tool on KGS website.

initials: ARL date: 1/26/2007

1	LOCATION OF WATER WELL:	Fraction	Section Number	Township Number	Range Number
County:	Douglas	SW 1/4 NE 1/4 NW 1/4	27	14	21

Distance and direction from nearest town or city street address of well if located within city?
 6 miles East and 1 1/2 miles N of Baldwin city

2 WATER WELL OWNER: Tray Holek
 RR#, St. Address, Box #: 234 West Park
 City, State, ZIP Code : Gardner, Ks. 66030
 Board of Agriculture, Division of Water Resources
 Application Number:

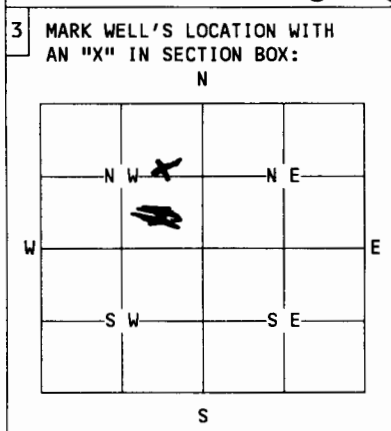

4 DEPTH OF WELL..... 221.....ft.
 WELL'S STATIC WATER LEVEL..... NONE.....ft.
 WELL WAS USED AS: Drilled for water and Plugged

1 Domestic	5 Public Water Supply	9 Dewatering
2 Irrigation	6 Oil Field Water Supply	10 Monitoring Well
3 Feedlot	7 Lawn and Garden Only	11 Injection Well
4 Industrial	8 Air Conditioning	12 Other.....

Was a chemical/bacteriological sample submitted to Department? Yes.....No X.
 If yes, mo/day/yr sample was submitted.....
 Water Well Disinfected: Yes..... No X.....

5 TYPE OF BLANK CASING USED: NONE

1 Steel	3 RMP (SR)	5 Wrought	7 Fiberglass	9 Other (specify below)
2 PVC	4 ABS	6 Asbestos-Cement	8 Concrete Tile	

Blank casing diameter.....in. Was casing pulled? Yes..... No..... If yes, how much.....
 Casing height above or below land surface.....in.

6 GROUT PLUG MATERIAL: 1 Neat cement 2 Cement grout 3 Bentonite 4 Other.....
 Grout Plug Intervals: From 221ft. to 0ft., From.....ft. to.....ft., From..... to.....ft.
 What is the nearest source of possible contamination: NONE

1 Septic tank	6 Seepage pit	11 Fuel storage	16 Other (specify below)
2 Sewer lines	7 Pit privy	12 Fertilizer storage	
3 Watertight sewer lines	8 Sewage lagoon	13 Insecticide storage	
4 Lateral lines	9 Feedyard	14 Abandoned water well	
5 Cess Pool	10 Livestock pens	15 Oil well/Gas well	

Direction from well? How many feet?

FROM	TO	PLUGGING MATERIALS
221	0	High Solids Bentonite
		0-8 Soil & clay
		8-12 Yellow sandstone
		12-136 Shale
		136-140 Limestone
		140-145 Shale
		145-159 Limestone
		159-168 blk shale
		168-177 Limestone
		177-181 Shale
		181-199 Limestone
		199-221 Shale

7 CONTRACTOR'S OR LANDOWNER'S CERTIFICATION: This water well was plugged under my jurisdiction and was completed on (mo/day/year) 1-8-07 and this record is true to the best of my knowledge and belief. Kansas Water Well Contractor's License No. 561. This Water Well Record was completed on (mo/day/year) 1-9-07 under the business name of Evans Energy Development Inc.
 by (signature) [Signature]

INSTRUCTIONS: Use typewriter or ball point pen. Please press firmly and print clearly. Please fill in blanks, underline or circle the correct answers. Send top three copies to Kansas Department of Health and Environment, Bureau of Water, Topeka, Kansas 66620-0001. Telephone: 785/296-3565. Send one to Water Well Owner and retain one for your records.