

WATER WELL PLUGGING RECORD Form WWC-5P KSA 82a-1212 ID NO.


1 LOCATION OF WATER WELL: County: <u>Johnson</u>	Fraction <u>W 1/2 SE 1/4 1/4</u>	Section Number <u>35</u>	Township Number <u>14</u>	Range Number <u>21</u> E/W
--	--	------------------------------------	-------------------------------------	--------------------------------------

Distance and direction from nearest town or city street address of well if located within city?

1 mile North of Edgerton 1 1/4 mile west on 181st street North side

2 WATER WELL OWNER: <u>Frank R Gieringer</u> RR#, St. Address, Box #: <u>39675 W 183rd Street</u> City, State ZIP Code: <u>Edgerton KS 66021</u>	Global Positioning Systems (decimal degrees, min. of 4 digits) Latitude: _____ Longitude: _____ Elevation: _____ Datum: _____ Data Collection Method: _____
--	---

3 MARK WELL'S LOCATION WITH AN "X" IN SECTION BOX:

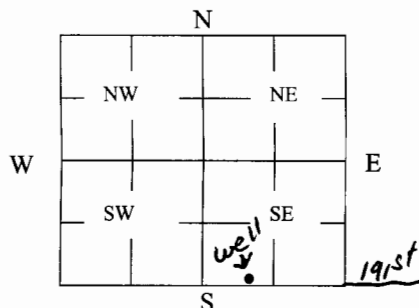

4 DEPTH OF WELL 30 ft.

WELL'S STATIC WATER LEVEL 10 ft

WELL WAS USED AS:

- | | | |
|--------------|----------------------------|-------------------------------------|
| 1 Domestic | 5 Public Water Supply | 9 Dewatering |
| 2 Irrigation | 6 Oil Field Water Supply | 10 Monitoring |
| 3 Feedlot | 7 Domestic (Lawn & Garden) | 11 Injection Well |
| 4 Industrial | 8 Air Conditioning | 12 Other <u>Abandoned Farm well</u> |

Was a chemical/bacteriological sample submitted to Department? Yes _____ No X

5 TYPE OF BLANK CASING USED:

- | | | | |
|---------|------------|-------------------|-----------------|
| 1 Steel | 3 RMP (SR) | 5 Wrought | 7 Fiberglass |
| 2 PVC | 4 ABS | 6 Asbestos-Cement | 8 Concrete Tile |

9 Other (Specify below)
Hand dug well

Blank casing diameter _____ in. Was casing pulled? Yes _____ No _____ If yes, how much _____
 Casing height above or below land surface _____ in.

6 GROUT PLUG MATERIAL: 1 Neat cement 2 Cement grout 3 Bentonite 4 Other _____

Grout Plug Intervals: From 10 ft. to 9 ft., From _____ ft. to _____ ft., From _____ to _____ ft.

What is the nearest source of possible contamination:

- | | | | |
|--------------------------|-------------------|-------------------------|---------------------------------------|
| 1 Septic tank | 6 Seepage pit | 11 Fuel Storage | 16 Other (specify below) |
| 2 Sewer lines | 7 Pit privy | 12 Fertilizer storage | <u>Nothing on farm / all tillable</u> |
| 3 Watertight sewer lines | 8 Sewage lagoon | 13 Insecticide storage | |
| 4 Lateral lines | 9 Feedyard | 14 Abandoned water well | Direction from well? _____ |
| 5 Cess pool | 10 Livestock pens | 15 Oil well/Gas well | How many feet? _____ |

FROM	TO	PLUGGING MATERIALS	FROM	TO	PLUGGING MATERIALS
30'	10'	granular Fill/Limestone Screenings	10'	9'	Bentonite clay
9'	3'	Compactd clay/Lining Rock	3'	Surface	Topsoil

7 CONTRACTOR'S OR LANDOWNER'S CERTIFICATION: This water well was plugged under my jurisdiction and was completed on (mo/day/year) Oct. 3 2011 and this record is true to the best of my knowledge and belief. Kansas Water Well Contractor's License No. _____. This Water Well Record was completed on (mo/day/year) Oct 3, 2011 under the business name of Gieringer Farm's by (signature) Frank Gieringer

INSTRUCTIONS: Use typewriter or ballpoint pen. Please press firmly and print clearly. Please fill in blanks, underline or circle the correct answers. Send top three copies to Kansas Department of Health and Environment, Bureau of Water, Geology Section, 1000 SW Jackson St., Ste. 420, Topeka, Kansas 66612-1367. Telephone: 785/296-5522. Send one to Water Well Owner and retain one for your records. Visit us at <http://www.kdheks.gov/geo/waterwells>.