

County: Johnson Fraction NE SE SE SE Sec. 1 T 14 S R 21 (EAW)

**CORRECTION(S) TO WATER WELL COMPLETION RECORD (WWC-5)**

(to rectify lacking or incorrect information)

Owner: Deloy Ussey

Location was listed as:

Section-Township-Range: None Given

Fraction (1/4 1/4 1/4): \_\_\_\_\_

Location changed to:

1-14S-21E

NE SE SE SE

Other changes: Initial statements: Latitude: 38.566533

Changed to: Latitude: 38.856533

Comments: \_\_\_\_\_

Verification method: corrected latitude & longitude, wellsite address, KGS' "LEO" lat/long conversion tool, area road map, and mapping tool & aerial photos on KGS website. initials: DRK date: 3/3/2017

Submitted by: Kansas Geological Survey, Data Resources Library, 1930 Constant Ave., Lawrence, KS 66047-3726

to: Kansas Dept of Health & Environment, Bureau of Water, 1000 SW Jackson, Suite 420, Topeka, KS 66612-1367.

**WATER WELL PLUGGING RECORD Form WWC-5P KSA 82a-1212 ID NO.**

\_\_\_\_\_

**1 LOCATION OF WATER WELL:** Fraction  1/4  1/4  1/4  1/4 Section Number \_\_\_\_\_ Township Number T S Range Number  E  W  
 County: JOHNSON


Street/Rural Address of Well Location; if unknown, distance & direction from nearest town or intersection: If at owner's address, check here

**Global Positioning Systems (GPS) information:**  
 Latitude: 38.566533 (in decimal degrees)  
 Longitude: -95.019676 (in decimal degrees)  
 Elevation: \_\_\_\_\_  
 Horizontal Datum:  WGS84,  NAD83,  NAD27  
 Collection Method: \_\_\_\_\_

**2 WATER WELL OWNER: DELOY USSERY**  
 RR#, St. Address, Box #: 15000 EDGERTON ROAD  
 City, State ZIP Code: GARDNER, KS 66030

GPS unit (Make/Model: \_\_\_\_\_)  
 Digital Map/Photo,  Topographic Map,  Land Survey  
 Est. Accuracy:  < 3 m,  3-5 m,  5-15 m,  > 15 m

**3 MARK WELL'S LOCATION WITH AN "X" IN SECTION BOX:**

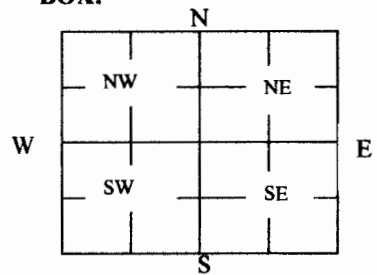

**4 DEPTH OF WELL 80 ft.**  
 WELL'S STATIC WATER LEVEL 25 ft

- WELL WAS USED AS:
- Domestic
  - Irrigation
  - Feedlot
  - Industrial
  - Public Water Supply
  - Oil Field Water Supply
  - Domestic (Lawn & Garden)
  - Air Conditioning
  - Dewatering
  - Monitoring
  - Injection Well
  - Other \_\_\_\_\_

Was a chemical/bacteriological sample submitted to Department? Yes  No

**5 TYPE OF BLANK CASING USED:**

- Steel
- RMP (SR)
- Wrought
- Fiberglass
- Other (Specify below) \_\_\_\_\_
- PVC
- ABS
- Asbestos-Cement
- Concrete Tile

Blank casing diameter 4 in. Was casing pulled? Yes  No  If yes, how much \_\_\_\_\_  
 Casing height above or below land surface 12 in.

**6 GROUT PLUG MATERIAL:**  Neat cement  Cement grout  Bentonite  Other \_\_\_\_\_

Grout Plug Intervals: From 80 ft. to 0 ft., From \_\_\_\_\_ ft. to \_\_\_\_\_ ft., From \_\_\_\_\_ ft. to \_\_\_\_\_ ft.

What is the nearest source of possible contamination:

- Septic tank
- Sewer lines
- Watertight sewer lines
- Lateral lines
- Cess pool
- Seepage pit
- Pit privy
- Sewage lagoon
- Feedyard
- Livestock pens
- Fuel storage
- Fertilizer storage
- Insecticide storage
- Abandoned water well
- Oil well/Gas well
- Other (specify below) \_\_\_\_\_

Direction from well? \_\_\_\_\_  
 How many feet? \_\_\_\_\_

FROM	TO	PLUGGING MATERIALS	FROM	TO	PLUGGING MATERIALS
80	0	HYDRATED BENTONITE CHIPS			

**7 CONTRACTOR'S OR LANDOWNER'S CERTIFICATION:** This water well was plugged under my jurisdiction and was completed on (mo/day/year) 02/01/2017 and this record is true to the best of my knowledge and belief. Kansas Water Well Contractor's License No. 561. This Water Well Record was completed on (mo/day/year) 02/02/2017 under the business name of EVANS ENERGY DEVELOPMENT, INC. by (signature) [Signature]

Send one white copy to Kansas Department of Health & Environment, Geology Section, 1000 SW Jackson Street, Ste. 420, Topeka, KS 66612-1367. Send one copy to WATER WELL OWNER and retain one for your records.  
 Visit us at <http://www.kdheks.gov/waterwell/index.html> Telephone 785-296-5524.