


1 LOCATION OF WATER WELL: County: Johnson Fraction SE 1/4 SW 1/4 SW 1/4 Section Number 24 Township Number T 14 S Range Number R 22 EW

Distance and direction from nearest town or city street address of well if located within city? 218 East Main, Gardner, Kansas

2 WATER WELL OWNER: Blue Ribbon Service RR#, St. Address, Box #: 314 E. Main Street City, State, ZIP Code: Gardner, Kansas 66030 Board of Agriculture, Division of Water Resources Application Number:

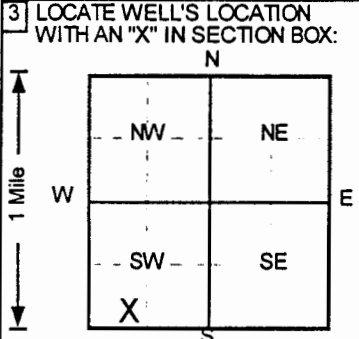

3 LOCATE WELL'S LOCATION WITH AN 'X' IN SECTION BOX: 4 DEPTH OF COMPLETED WELL: 13 ft ELEVATION: 1070.23 Depth(s) Groundwater Encountered: 2.6 ft 3. ft WELL'S STATIC WATER LEVEL: 2.63 ft below land surface measured on 7/10/97 Pump test data: Well water was NA ft after hours pumping gpm Est Yield NA gpm: Well water was ft after hours pumping gpm Bore Hole Diameter: 8 in. to 13 ft, and in. to ft WELL WATER TO BE USED AS: 5 Public water supply 8 Air conditioning 11 Injection well 1 Domestic 3 Feedlot 6 Oil field water supply 9 Dewatering 12 Other (Specify below) 2 Irrigation 4 Industrial 7 Lawn and garden only 10 Monitoring well Was a chemical/bacteriological sample submitted to Department? Yes No; If yes, mo/day/yr sample was submitted Water Well Disinfected? Yes No

5 TYPE OF BLANK CASING USED: 1 Steel 3 RMP (SR) 5 Wrought iron 8 Concrete tile CASING JOINTS: Glued Clamped 2 PVC 4 ABS 7 Fiberglass 9 Other (specify below) Welded Threaded Blank casing diameter: 2 in. to 3 ft, Dia in. to ft, Dia in. to ft Casing height above land surface: -4.8 in., weight Sch 40 lbs./ft. Wall thickness or gauge No. TYPE OF SCREEN OR PERFORATION MATERIAL: 1 Steel 3 Stainless steel 5 Fiberglass 7 PVC 10 Asbestos-cement 2 Brass 4 Galvanized steel 6 Concrete tile 9 ABS 11 Other (specify) 12 None used (open hole) SCREEN OR PERFORATION OPENINGS ARE: 1 Continuous slot 3 Mill slot 5 Gauzed wrapped 8 Saw cut 11 None (open hole) 2 Louvered shutter 4 Key punched 6 Wire wrapped 9 Drilled holes 10 Other (specify) SCREEN-PERFORATED INTERVALS: From 3 ft to 13 ft, From ft to ft GRAVEL PACK INTERVALS: From 2 ft to 13 ft, From ft to ft

6 GROUT MATERIAL: 1 Neat cement 2 Cement grout 3 Bentonite 4 Other Grout Intervals: From 0 ft to 1 ft, From 1 ft to 2 ft, From ft to ft What is the nearest source of possible contamination: 1 Septic tank 4 Lateral lines 7 Pit privy 10 Livestock pens 14 Abandoned water well 2 Sewer lines 5 Cess pool 8 Sewage lagoon 11 Fuel storage 15 Oil well/Gas well 3 Watertight sewer lines 6 Seepage pit 9 Feedyard 12 Fertilizer storage 16 Other (specify below) Former UST Basin Direction from well? On top of How many feet? 0

Table with columns: FROM, TO, LITHOLOGIC LOG, FROM, TO, PLUGGING INTERVALS. Rows include: 0-0.5 Concrete, 0.5-2 Clay, Dark Brown, 2-7 Gravel, White, 7-11 Sand, Brown, 11-13 Clay, Brown. Additional info: MW1, Tag # 00180593, Flushmount; Project Name: Blue Ribbon Service; GeoCore # 469, KDHE # U4 046 708

7 CONTRACTOR'S OR LANDOWNER'S CERTIFICATION: This water well was (1) constructed, (2) reconstructed, or (3) plugged under my jurisdiction and was completed on (mo/day/year) 6/26/97 and this record is true to the best of my knowledge and belief. Kansas Water Well Contractor's License No. 527 This Water Well Record was completed on (mo/day/yr) 8/8/97 under the business name of GeoCore Services, Inc. by (signature) Derle A. Hall

INSTRUCTIONS: Use typewriter or ball point pen. PLEASE PRESS FIRMLY and PRINT clearly. Please fill in blanks, underline or circle the correct answers. Send top three copies to Kansas Department of Health and Environment, Bureau of Water, Topeka, Kansas 66820-0001. Telephone: 913-296-5545. Send one to WATER WELL OWNER and retain one for your records.

OFFICE USE ONLY T R SEC 1/2 3/4