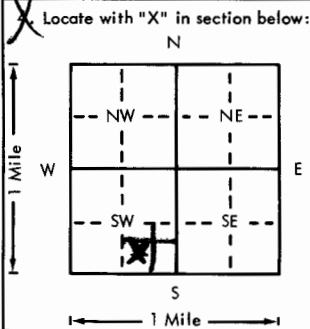
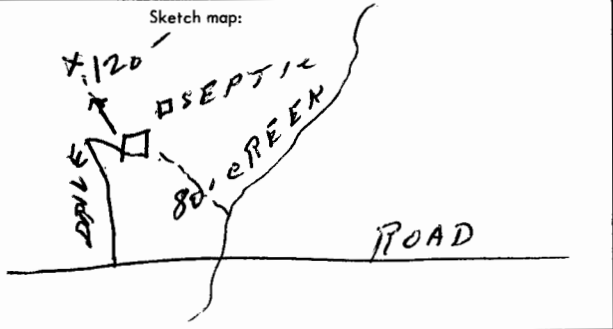


Point ch

USE TYPEWRITER OR BALL
POINT PEN-PRESS FIRMLY,
PRINT CLEARLY.

WATER WELL RECORD
KSA 82a-1201-1215

Kansas Department of Health and
Environment-Division of Environment
(Water well Contractors)
Topeka, Kansas 66620

1. Location of well:		County Johnson	Section SW 1/4 SE 1/4 SW 1/4	Section number 33	Township number T 14 S R 22 E	Range number E/W	
2. Distance and direction from nearest town or city: 2 1/2 mi. SW gardner, Ks			3. Owner of well: Royl K. Wilson R.R. or street: 12920 W. 96th City, state, zip code: Lenexa, Ks. 66215				
Locate with "X" in section below: 			Sketch map: 			6. Bore hole dia. 8 1/2 in. Completion date 8-5-76 Well depth 149 ft.	
5. Type and color of material			From		To		
surface			0		4		
lime			4		12		
shale (dark)			12		18		
lime			18		29		
shale (med. grey)			29		36		
lime (med. grey)			36		57		
shale (greenish grey)			57		74		
lime			74		105		
shale (med. grey)			105		130		
lime (lt. grey)			130		134		
shale (dk. gummy)			134		138		
lime			138		145		
lime			145		149		
CASING DRILLED AND SLOTTED 30' to 149'							
perforations: 3/32							
customer installed water system							
(Use a second sheet if needed)							
18. Elevation: 980 Topography: <input type="checkbox"/> Hill <input checked="" type="checkbox"/> Slope <input type="checkbox"/> Upland <input type="checkbox"/> Valley		19. Remarks: Customer is aware of State regulation and agrees to install a 4' square fire-enforced concrete platform around top of well. X R. Wilson		20. Water well contractor's certification: This well was drilled under my jurisdiction and this report is true to the best of my knowledge and belief. F.E. Young Drilling 240 Business name 6355 Robinhood Ln. License No. 10-3-76 Address F.E. Young Date 10-3-76 Signed F.E. Young Authorized representative			

Forward the white, blue and pink copies to the Department of Health and Environment

Form WWC-5