

WATER WELL PLUGGING RECORD Form WWC-5P

KSA 82a-1212

ID NO.

015 8145

1 LOCATION OF WATER WELL:

County: Johnson

Fraction

SE 1/4 SE 1/4 SW 1/4

Section Number

24

Township Number

14

Range Number

22 EW

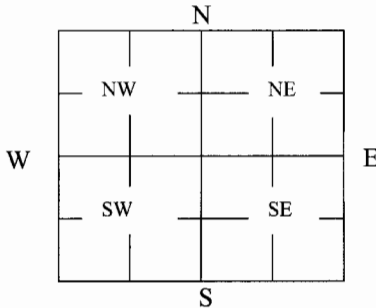
Distance and direction from nearest town or city street address of well if located within city?

432 E. Main St. Gardner, KS2 WATER WELL OWNER: M+M Oil CompanyRR#, St. Address, Box #: Box 171City, State ZIP Code: Lawrence, KS 66044

Global Positioning Systems (decimal degrees, min. of 4 digits)

Latitude: 38°N, 48.66'Longitude: 94°W, 55.20'Elevation: 1055'Datum: NADData Collection Method: USGS Topo map

3 MARK WELL'S LOCATION WITH AN "X" IN SECTION BOX:

4 DEPTH OF WELL 10.5 ft.WELL'S STATIC WATER LEVEL 3.0 ft

WELL WAS USED AS:

1 Domestic

2 Irrigation

3 Feedlot

4 Industrial

5 Public Water Supply

6 Oil Field Water Supply

7 Domestic (Lawn & Garden)

8 Air Conditioning

9 Dewatering

10 Monitoring

11 Injection Well

12 Other

Was a chemical/bacteriological sample submitted to Department? Yes No X

5 TYPE OF BLANK CASING USED:

1 Steel

3 RMP (SR)

5 Wrought

7 Fiberglass

9 Other (Specify below)

2 PVC

4 ABS

6 Asbestos-Cement

8 Concrete Tile

Blank casing diameter 2 in. Was casing pulled? Yes X No If yes, how much overdrill to 14.5
Casing height above or below land surface N/A in.6 GROUT PLUG MATERIAL: 1 Neat cement 2 Cement grout 3 Bentonite 4 OtherGrout Plug Intervals: From 14.5 ft. to 1 ft., From ft. to ft., From to ft.

What is the nearest source of possible contamination:

1 Septic tank

6 Seepage pit

11 Fuel Storage

16 Other (specify below)

2 Sewer lines

7 Pit privy

12 Fertilizer storage

3 Watertight sewer lines

8 Sewage lagoon

13 Insecticide storage

4 Lateral lines

9 Feedyard

14 Abandoned water well

Direction from well?

5 Cess pool

10 Livestock pens

15 Oil well/Gas well

How many feet?

FROM	TO	PLUGGING MATERIALS	FROM	TO	PLUGGING MATERIALS
<u>14.5</u>	<u>1</u>	<u>Bentonite</u>			
<u>1</u>	<u>0</u>	<u>native surface</u>			

7 CONTRACTOR'S OR LANDOWNER'S CERTIFICATION: This water well was plugged under my jurisdiction and was completed on (mo/day/year) 9/13/06 and this record is true to the best of my knowledge and belief. Kansas Water Well Contractor's License No. 594. This Water Well Record was completed on (mo/day/year) 9/25/06 under the business name of Coranco Great Plains, Inc by (signature) [Signature]

INSTRUCTIONS: Use typewriter or ballpoint pen. Please press firmly and print clearly. Please fill in blanks, underline or circle the correct answers. Send top three copies to Kansas Department of Health and Environment, Bureau of Water, Geology Section, 1000 SW Jackson St., Ste. 420, Topeka, Kansas 66612-1367. Telephone: 785/296-5522. Send one to Water Well Owner and retain one for your records. Visit us at <http://www.kdheks.gov/geo/waterwells>.