WATER WELL RECORD Form WWC-5 KSA 82a-1212 K9405 MW-04-01

1 LOCATION OF WATER WELL: County: Johnson	Fraction: NE ¼ SE ¼ SW ¼	Section Number: 7	Township Number: T 14 S	Range Number: R 23 (E) W

Distance and direction from nearest town or city street address of well if located within city?
700' NW of Intersection of 159th st. and Lenexa Dr.

2 WATER WELL OWNER: U.S. Army Corps of Engineers Kansas City Dist.
RR#, St. Address, Box # : 600 E 12th street
City, State, ZIP Code : Kansas City, Missouri

Board of Agriculture, Division of Water Resources Application Number:

3 LOCATE WELL'S LOCATION WITH AN "X" IN SECTION BOX:

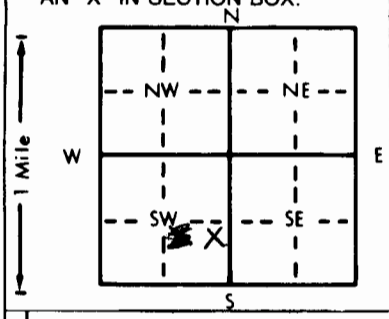

4 DEPTH OF COMPLETED WELL 50 ft. ELEVATION: 1074.6
Depth(s) Groundwater Encountered 1. N/A ft. 2. ft. 3.
WELL'S STATIC WATER LEVEL 10.78 ft. below land surface measured on mo/day/yr 9-19-95
Pump test data: Well water was ft. after hours pumping gpm
Est. Yield <1 gpm: Well water was ft. after hours pumping gpm
Bore Hole Diameter 8 in. to 17.5 ft., and 3 in. to 50.0 ft.
WELL WATER TO BE USED AS: 1 Domestic 2 Irrigation 3 Feedlot 4 Industrial 5 Public water supply 6 Oil field water supply 7 Lawn and garden only 8 Air conditioning 9 Dewatering 10 (Monitoring well) 11 Injection well 12 Other (Specify below)
Was a chemical/bacteriological sample submitted to Department? Yes No X; If yes, mo/day/yr sample was submitted
Water Well Disinfected? Yes (No)

5 TYPE OF BLANK CASING USED: 1 Steel 2 (PVC) 3 RMP (SR) 4 ABS 5 Wrought iron 6 Asbestos-Cement 7 Fiberglass 8 Concrete tile 9 Other (specify below)
CASING JOINTS: Glued Clamped Welded (Threaded)
Blank casing diameter 4 in. to 17.5 ft., Dia in. to ft., Dia in. to ft.
Casing height above land surface 24 in., weight lbs./ft. Wall thickness or gauge No. Sch 80
TYPE OF SCREEN OR PERFORATION MATERIAL: 1 Steel 2 Brass 3 Stainless steel 4 Galvanized steel 5 Fiberglass 6 Concrete tile 7 PVC 8 RMP (SR) 9 ABS 10 Asbestos-cement 11 Other (specify) 12 (None used (open hole))
SCREEN OR PERFORATION OPENINGS ARE: 1 Continuous slot 2 Louvered shutter 3 Mill slot 4 Key punched 5 Gauzed wrapped 6 Wire wrapped 7 Torch cut 8 Saw cut 9 Drilled holes 10 Other (specify) 11 (None (open hole))
SCREEN-PERFORATED INTERVALS: From ~~17.5~~ N/A ft. to ~~50.0~~ ft., From ft. to ft.
From ft. to ft., From ft. to ft.
GRAVEL PACK INTERVALS: From N/A ft. to ft., From ft. to ft.
From ft. to ft., From ft. to ft.

6 GROUT MATERIAL: 1 Neat cement 2 Cement grout (3 Bentonite) 4 Other Cement-Bentonite Grout
Grout Intervals: 4 From 1.5 ft. to 15.5 ft., 3 From 15.5 ft. to 17.5 ft., From ft. to ft.
What is the nearest source of possible contamination: 1 Septic tank 2 Sewer lines 3 Watertight sewer lines 4 Lateral lines 5 Cess pool 6 Seepage pit 7 Pit privy 8 Sewage lagoon 9 Feedyard 10 Livestock pens 11 Fuel storage 12 Fertilizer storage 13 Insecticide storage 14 Abandoned water well 15 Oil well/Gas well (16 Other (specify below)) Landfill
Direction from well? WEST How many feet? 260'

FROM	TO	LITHOLOGIC LOG	FROM	TO	PLUGGING INTERVALS
0.0	11.4	CLAY			
11.4	12.5	SHALE			
12.5	15.5	LIMESTONE			
15.5	19.1	Sandstone			
19.1	20.4	LIMESTONE			
20.4	25.0	SANDSTONE			* well originally drilled on 8-5-95 with surface completion on 8-31-95. Well redevelopment completed, thru 9-20-95
25.0	26.2	SHALE			
26.2	43.2	LIMESTONE			
43.2	50.0	SHALE			

7 CONTRACTOR'S OR LANDOWNER'S CERTIFICATION: This water well was (1) (constructed) (2) reconstructed, or (3) plugged under my jurisdiction and was completed on (mo/day/year) 9-20-95 * and this record is true to the best of my knowledge and belief. Kansas Water Well Contractor's License No. 399 This Water Well Record was completed on (mo/day/yr) 10-13-95 under the business name of Woodward Clyde Consultants by (signature) [signature]

INSTRUCTIONS: Use typewriter or ball point pen. *PLEASE PRESS FIRMLY* and *PRINT* clearly. Please fill in blanks, underline or circle the correct answers. Send top three copies to Kansas Department of Health and Environment, Bureau of Water, Topeka, Kansas 66620-0001. Telephone: 913-296-5545. Send one to WATER WELL OWNER and retain one for your records.

OFFICE USE ONLY T R E/W SEC. ¼ ¼ ¼