


1 LOCATION OF WATER WELL: Fraction **SE 1/4 NW 1/4 SW 1/4** Section Number **18** Township Number **T 14 S** Range Number **R 23 EW**
 County: **Johnson**

Distance and direction from nearest town or city street address of well if located within city?
.2 mi East and 400' N of Intersection 166th St. and Moonlight Rd.

2 WATER WELL OWNER: **U.S. Army Corps of Engineers Kansas City Dist.**
 RR#, St. Address, Box #: **600 E. 12th Street** Board of Agriculture, Division of Water Resources
 City, State, ZIP Code: **Kansas City, Missouri** Application Number:

3 LOCATE WELL'S LOCATION WITH AN "X" IN SECTION BOX:

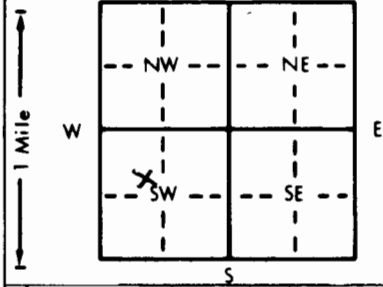

4 DEPTH OF COMPLETED WELL: **29.5** ft. ELEVATION: **1061.0**
 Depth(s) Groundwater Encountered 1. **N/A** ft. 2. ft. 3. ft.
 WELL'S STATIC WATER LEVEL: **25** ft. below land surface measured on mo/day/yr **10-2-95**
 Pump test data: Well water was ft. after hours pumping gpm
 Est. Yield **2.1** gpm Well water was ft. after hours pumping gpm
 Bore Hole Diameter: **8** in. to **20.1** ft., and **3** in. to **29.5** ft.
 WELL WATER TO BE USED AS:
 5 Public water supply 8 Air conditioning 11 Injection well
 1 Domestic 3 Feedlot 6 Oil field water supply 9 Dewatering 12 Other (Specify below)
 2 Irrigation 4 Industrial 7 Lawn and garden only 10 **Monitoring well**
 Was a chemical/bacteriological sample submitted to Department? Yes No **X**; If yes, mo/day/yr sample was submitted
 Water Well Disinfected? Yes **No**

5 TYPE OF BLANK CASING USED:
 1 **Steel** 3 RMP (SR) 5 Wrought iron 8 Concrete tile CASING JOINTS: Glued Clamped
 2 **PVC** 4 ABS 6 Asbestos-Cement 9 Other (specify below) Welded
 7 Fiberglass **Threaded**
 Blank casing diameter **4** in. to **20.1** ft., Dia. in. to ft., Dia. in. to ft.
 Casing height above land surface **26** in., weight lbs./ft. Wall thickness or gauge No. **Sch 80**
 TYPE OF SCREEN OR PERFORATION MATERIAL:
 1 Steel 3 Stainless steel 5 Fiberglass 7 PVC 10 Asbestos-cement
 2 Brass 4 Galvanized steel 6 Concrete tile 8 RMP (SR) 11 Other (specify)
 9 ABS **2 None used (open hole)**
 SCREEN OR PERFORATION OPENINGS ARE:
 5 Gauzed wrapped 8 Saw cut 11 **None (open hole)**
 1 Continuous slot 3 Mill slot 6 Wire wrapped 9 Drilled holes
 2 Louvered shutter 4 Key punched 7 Torch cut 10 Other (specify)
 SCREEN-PERFORATED INTERVALS: From **20.1 N/A** ft. to **29.5** ft., From ft. to ft.
 From ft. to ft., From ft. to ft.
 GRAVEL PACK INTERVALS: From **N/A** ft. to ft., From ft. to ft.
 From ft. to ft., From ft. to ft.

6 GROUT MATERIAL: 1 Neat cement 2 Cement grout 3 **Bentonite** 4 Other **Cement-Bentonite grout**
 Grout Intervals **4** From **1.5** ft. to **18.0** ft., From **18.0** ft. to **20.1** ft., From ft. to ft.
 What is the nearest source of possible contamination:
 1 Septic tank 4 Lateral lines 7 Pit privy 10 Livestock pens 14 Abandoned water well
 2 Sewer lines 5 Cess pool 8 Sewage lagoon **11 Fuel storage** 15 Oil well/Gas well
 3 Watertight sewer lines 6 Seepage pit 9 Feedyard 12 Fertilizer storage 16 Other (specify below)
 13 Insecticide storage
 Direction from well? **Southeast** How many feet? **65'**

FROM	TO	LITHOLOGIC LOG	FROM	TO	PLUGGING INTERVALS
0.0	8.0	CLAY			
8.0	17.6	SHALE			
17.6	25.1	LIMESTONE			
25.1	29.5	SHALE			

** well originally drilled on 9-13-95. MW completed on 10-2-95*

7 CONTRACTOR'S OR LANDOWNER'S CERTIFICATION: This water well was **1** constructed, **2** reconstructed, or **3** plugged under my jurisdiction and was completed on (mo/day/year) **10-2-95** and this record is true to the best of my knowledge and belief. Kansas Water Well Contractor's License No. **399** This Water Well Record was completed on (mo/day/yr) **10-19-95**
 under the business name of **Woodward Clyde Consultants** by (signature) *[Signature]*