WATER WELL RECORD Form WWC-5 KSA 82a-1212 K9405 MW-10-02

1 LOCATION OF WATER WELL: County: Johnson	Fraction: SW ¼ SW ¼ SW ¼	Section Number: 18	Township Number: T 14 S	Range Number: R 23 (E) W

Distance and direction from nearest town or city street address of well if located within city?
200' S and 300' E of Intersection of Moonlight Rd. and 166 st.

2 WATER WELL OWNER: U.S. Army Corps of Engineers Kansas City Dist.
RR#, St. Address, Box # : 600 E. 12th street
City, State, ZIP Code : Kansas City, Missouri

Board of Agriculture, Division of Water Resources
Application Number:

3 LOCATE WELL'S LOCATION WITH AN "X" IN SECTION BOX:

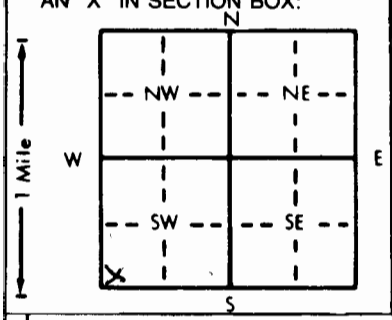

4 DEPTH OF COMPLETED WELL 35.0 ft. ELEVATION: 1054.4
Depth(s) Groundwater Encountered 1. N/A ft. 2. ft. 3. ft.
WELL'S STATIC WATER LEVEL 7.75 ft. below land surface measured on mo/day/yr 9-5-95
Pump test data: Well water was ft. after hours pumping gpm
Est. Yield 21 gpm: Well water was ft. after hours pumping gpm
Bore Hole Diameter 8 in. to 20.0 ft., and 3 in. to 35 ft.
WELL WATER TO BE USED AS: 5 Public water supply 8 Air conditioning 11 Injection well
1 Domestic 3 Feedlot 6 Oil field water supply 9 Dewatering 12 Other (Specify below)
2 Irrigation 4 Industrial 7 Lawn and garden only 10 Monitoring well
Was a chemical/bacteriological sample submitted to Department? Yes No X; If yes, mo/day/yr sample was submitted
Water Well Disinfected? Yes No

5 TYPE OF BLANK CASING USED: 5 Wrought iron 8 Concrete tile CASING JOINTS: Glued Clamped
1 Steel 3 RMP (SR) 6 Asbestos-Cement 9 Other (specify below) Welded
2 PVC 4 ABS 7 Fiberglass Threaded
Blank casing diameter 4 in. to 20 ft., Dia in. to ft., Dia in. to ft.
Casing height above land surface 24 in., weight lbs./ft. Wall thickness or gauge No. Sch. 80
TYPE OF SCREEN OR PERFORATION MATERIAL: 7 PVC 10 Asbestos-cement
1 Steel 3 Stainless steel 5 Fiberglass 8 RMP (SR) 11 Other (specify)
2 Brass 4 Galvanized steel 6 Concrete tile 9 ABS 12 None used (open hole)
SCREEN OR PERFORATION OPENINGS ARE: 5 Gauzed wrapped 8 Saw cut 11 None (open hole)
1 Continuous slot 3 Mill slot 6 Wire wrapped 9 Drilled holes
2 Louvered shutter 4 Key punched 7 Torch cut 10 Other (specify)
SCREEN-PERFORATED INTERVALS: From 20.0 ft. to 35.0 ft., From ft. to ft.
From ft. to ft., From ft. to ft.
GRAVEL PACK INTERVALS: From ft. to ft., From ft. to ft.
From ft. to ft., From ft. to ft.

6 GROUT MATERIAL: 1 Neat cement 2 Cement grout 3 Bentonite 4 Other Cement-Bentonite grout
Grout Intervals: 1 From 1.5 ft. to 18.0 ft., 3 From 18.0 ft. to 20.0 ft., From ft. to ft.
What is the nearest source of possible contamination: 10 Livestock pens 14 Abandoned water well
1 Septic tank 4 Lateral lines 7 Pit privy 11 Fuel storage 15 Oil well/Gas well
2 Sewer lines 5 Cess pool 8 Sewage lagoon 12 Fertilizer storage 16 Other (specify below)
3 Watertight sewer lines 6 Seepage pit 9 Feedyard 13 Insecticide storage Lead Storage
Direction from well? SOUTH How many feet? 685'

FROM	TO	LITHOLOGIC LOG	FROM	TO	PLUGGING INTERVALS
0	13	CLAY			
13	13.8	Shale			
13.8	17.2	Limestone			
17.2	19.5	Sandstone-Limestone			
19.5	25.3	Sandstone-Shale			
25.3	26.8	Shale			
26.8	35.0	Limestone			
					* Well Completed with Development on 10-10-95

7 CONTRACTOR'S OR LANDOWNER'S CERTIFICATION: This water well was (1) constructed, (2) reconstructed, or (3) plugged under my jurisdiction and was completed on (mo/day/year) 9-5-95 * and this record is true to the best of my knowledge and belief. Kansas Water Well Contractor's License No. 399 This Water Well Record was completed on (mo/day/yr) 10-18-95 under the business name of Woodward Clyde Consultants by (signature) Richard R. Mihach

INSTRUCTIONS: Use typewriter or ball point pen. *PLEASE PRESS FIRMLY* and *PRINT* clearly. Please fill in blanks, underline or circle the correct answers. Send top three copies to Kansas Department of Health and Environment, Bureau of Water, Topeka, Kansas 66620-0001. Telephone: 913-296-5545. Send one to WATER WELL OWNER and retain one for your records.

OFFICE USE ONLY T R E/W SEC. ¼ ¼ ¼ ¼