
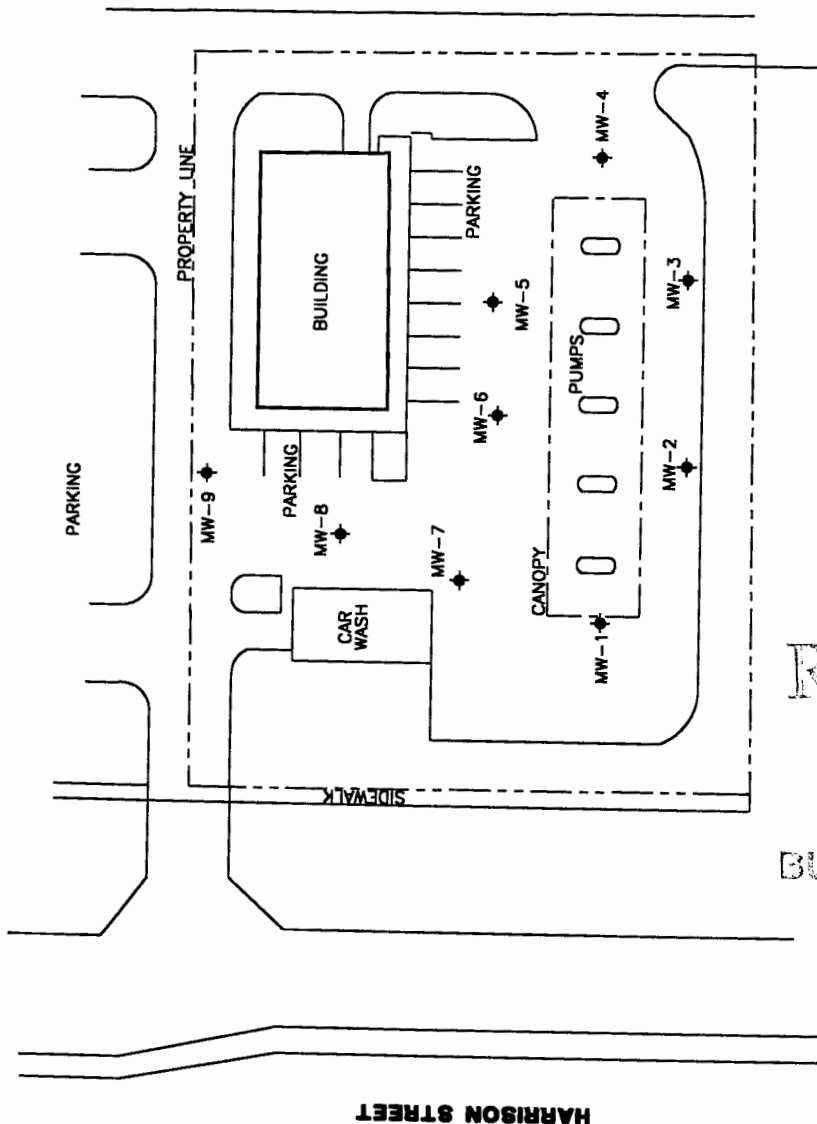


4.

LEGEND

◆ MONITORING WELL

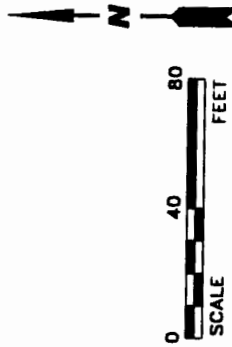

IT CORPORATION
4400 COLLEGE BOULEVARD
SUITE 180 OVERLAND PARK, KS 66211
(913) 481-1224

REV. NO.: DRAWING DATE: 9/21/99 ACAD FILE: 2311MWL

MONITORING WELL LOCATION MAP

CLIENT: ASAP #2311 PM: JL
LOCATION: 1020 SOUTH HARRISON STREET OLATHE, KS
DESIGNED: RHW PROJECT NO.: 796895
FIGURE: 0

U.S. HIGHWAY 66

RECEIVED

05 27 1999

BUREAU OF WATER

RECEIVED

SEP 30 1999

BUREAU OF WATER