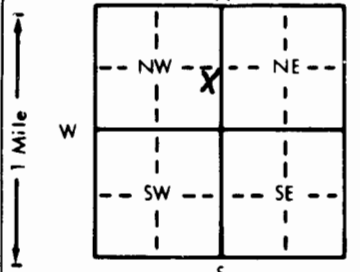


mw-3

1 LOCATION OF WATER WELL: County: Johnson		Fraction SE 1/4 SE 1/4 NW 1/4	Section Number 14	Township Number T 14 S	Range Number R 23 E/W																								
Distance and direction from nearest town or city street address of well if located within city? 407 N. Webster, Spring Hill, KS																													
2 WATER WELL OWNER: RR#, St. Address, Box # : John's Service City, State, ZIP Code : 407 N. Webster, Spring Hill, Ks 66083 Board of Agriculture, Division of Water Resources Application Number: -----																													
3 LOCATE WELL'S LOCATION WITH AN "X" IN SECTION BOX: 		4 DEPTH OF COMPLETED WELL: 15 ft. ELEVATION: ----- Depth(s) Groundwater Encountered 1. 7 ft. 2. ----- ft. 3. ----- ft. WELL'S STATIC WATER LEVEL 2.80 ft. below land surface measured on mo/day/yr NA Pump test data: Well water was ----- ft. after ----- hours pumping ----- gpm Est. Yield ----- gpm: Well water was ----- ft. after ----- hours pumping ----- gpm Bore Hole Diameter: 8.625 in. to 15 ft., and ----- in. to ----- ft. WELL WATER TO BE USED AS: 5 Public water supply 8 Air conditioning 11 Injection well 1 Domestic 3 Feedlot 6 Oil field water supply 9 Dewatering 12 Other (Specify below) 2 Irrigation 4 Industrial 7 Lawn and garden only 10 Monitoring well mw-3 Was a chemical/bacteriological sample submitted to Department? Yes ----- No X ; If yes, mo/day/yr sample was submitted ----- Water Well Disinfected? Yes ----- No X																											
5 TYPE OF BLANK CASING USED: 1 Steel 3 RMP (SR) 5 Wrought iron 8 Concrete tile CASING JOINTS: Glued ----- Clamped ----- 2 PVC 4 ABS 6 Asbestos-Cement 9 Other (specify below) Welded ----- Blank casing diameter 2 in. to 5 ft., Dia ----- in. to ----- ft., Dia ----- in. to ----- ft. Casing height above land surface 0 in., weight SCH 40 PVC lbs./ft. Wall thickness or gauge No. ----- TYPE OF SCREEN OR PERFORATION MATERIAL: 1 Steel 3 Stainless steel 5 Fiberglass 8 RMP (SR) 10 Asbestos-cement 2 Brass 4 Galvanized steel 6 Concrete tile 9 ABS 11 Other (specify) ----- 12 None used (open hole) SCREEN OR PERFORATION OPENINGS ARE: 1 Continuous slot 3 Mill slot 5 Gauzed wrapped 8 Saw cut 11 None (open hole) 2 Louvered shutter 4 Key punched 7 Torch cut 9 Drilled holes 10 Other (specify) ----- SCREEN-PERFORATED INTERVALS: From 5 ft. to 15 ft., From ----- ft. to ----- ft., From ----- ft. to ----- ft. SAND From ----- ft. to ----- ft., From ----- ft. to ----- ft., From ----- ft. to ----- ft. GRAVEL PACK INTERVALS: From 4 ft. to 15 ft., From ----- ft. to ----- ft., From ----- ft. to ----- ft.																													
6 GROUT MATERIAL: 1 Neat cement 2 Cement grout 3 Bentonite 4 Other ----- Grout Intervals: From 20 ft. to 2 ft., From 3 ft. to 2 ft., From 0 ft. to 4 ft., From ----- ft. to ----- ft. What is the nearest source of possible contamination: 1 Septic tank 4 Lateral lines 7 Pit privy 10 Livestock pens 14 Abandoned water well 2 Sewer lines 5 Cess pool 8 Sewage lagoon 11 Fuel storage 15 Oil well/Gas well 3 Watertight sewer lines 6 Seepage pit 9 Feedyard 12 Fertilizer storage 16 Other (specify below) cont. set 13 Insecticide storage Direction from well? How many feet? FROM TO LITHOLOGIC LOG FROM TO PLUGGING INTERVALS																													
<table border="1" style="width:100%; border-collapse: collapse;"> <tr> <td>GL</td> <td>1.00</td> <td>Soil</td> <td></td> <td></td> <td></td> </tr> <tr> <td>1.00</td> <td>4.00</td> <td>Clay, dark brown</td> <td></td> <td></td> <td></td> </tr> <tr> <td>4.00</td> <td>15.00</td> <td>Clay, brown</td> <td></td> <td></td> <td></td> </tr> <tr> <td>15.00</td> <td>TD</td> <td>End of Borehole</td> <td></td> <td></td> <td></td> </tr>
7 CONTRACTOR'S OR LANDOWNER'S CERTIFICATION: This water well was (1) constructed , (2) reconstructed, or (3) plugged under my jurisdiction and was completed on (mo/day/year) 1-12-98 and this record is true to the best of my knowledge and belief. Kansas Water Well Contractor's License No. 585 This Water Well Record was completed on (mo/day/yr) 1-17-98 under the business name of AGI by (signature) John P. Puma																													