

12+169.074

38.877 Rt

WATER WELL PLUGGING RECORD Form WWC-5P

KSA 82a-1212

ID NO.

1 LOCATION OF WATER WELL:

County: Johnson

Fraction

SW 1/4 NW 1/4 SW 1/4

Section Number

11

Township Number

T14S

Range Number

R23 EW

Distance and direction from nearest town or city street address of well if located within city?

159th Street & Lone Elm Road City of Olathe KS (66061)

2 WATER WELL OWNER:

RR#, St. Address, Box #:

City, State ZIP Code:

Global Positioning Systems (decimal degrees, min. of 4 digits)

Latitude: _____

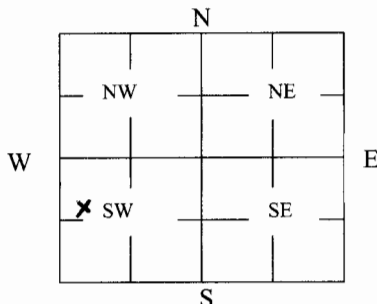
Longitude: _____

Elevation: _____

Datum: _____

Data Collection Method: _____

3 MARK WELL'S LOCATION WITH AN "X" IN SECTION BOX:

4 DEPTH OF WELL 15'-6" ft. (Existing Ground Depth)WELL'S STATIC WATER LEVEL 0 ft

WELL WAS USED AS:

1 Domestic

2 Irrigation

3 Feedlot

4 Industrial

5 Public Water Supply

6 Oil Field Water Supply

7 Domestic (Lawn & Garden)

8 Air Conditioning

9 Dewatering

10 Monitoring

11 Injection Well

12 Other _____

Was a chemical/bacteriological sample submitted to Department? Yes _____ No _____

5 TYPE OF BLANK CASING USED: N/A

1 Steel

3 RMP (SR)

5 Wrought

7 Fiberglass

9 Other (Specify below)

2 PVC

4 ABS

6 Asbestos-Cement

8 Concrete Tile

Blank casing diameter _____ in. Was casing pulled? Yes _____ No _____ If yes, how much _____

Casing height above or below land surface _____ in.

6 GROUT PLUG MATERIAL:

1 Neat cement

2 Cement grout

3 Bentonite

4 Other ConcreteGrout Plug Intervals: From 0 ft. to 1 ft., From _____ ft. to _____ ft., From _____ to _____ ft.

What is the nearest source of possible contamination:

1 Septic tank

6 Seepage pit

11 Fuel Storage

16 Other (specify below)

2 Sewer lines

7 Pit privy

12 Fertilizer storage

3 Watertight sewer lines

8 Sewage lagoon

13 Insecticide storage

4 Lateral lines

9 Feedyard

14 Abandoned water well

Direction from well? _____

5 Cess pool

10 Livestock pens

15 Oil well/Gas well

How many feet? _____

FROM	TO	PLUGGING MATERIALS	FROM	TO	PLUGGING MATERIALS
<u>-15'-6"</u>	<u>-1'</u>	<u>Gravel (23 Cu ft)</u>			
<u>-1'</u>	<u>0</u>	<u>Concrete Cap (16 Cu ft)</u>			
<u>0</u>	<u>+2'</u>	<u>Soil (Clay)</u>			

7 CONTRACTOR'S OR LANDOWNER'S CERTIFICATION: This water well was plugged under my jurisdiction and was completed on (mo/day/year) 6/11/10 and this record is true to the best of my knowledge and belief. Kansas Water Well Contractor's License No. _____. This Water Well Record was completed on (mo/day/year) 6/16/10 under the business name of APAC Kansas, Inc. by (signature) [Signature] P.E.

INSTRUCTIONS: Use typewriter or ballpoint pen. Please press firmly and print clearly. Please fill in blanks, underline or circle the correct answers. Send top three copies to Kansas Department of Health and Environment, Bureau of Water, Geology Section, 1000 SW Jackson St., Ste. 420, Topeka, Kansas 66612-1367. Telephone: 785/296-5522. Send one to Water Well Owner and retain one for your records. Visit us at <http://www.kdheks.gov/geo/waterwells>.



APAC-Kansas, Inc.

Kansas City Division
7415 W. 130th Street, Suite 300
P.O. Box 23910
Overland Park, KS 66283
Tel: 913-814-6700, Fax: 913-814-6766

June 16, 2010

Kansas Department of Health & Environment
Bureau of Water, Geology Section
1000 SW Jackson Street, Ste 420
Topeka, Kansas 66612-1367

Re: Johnson County, 35-46 K 9014-01
Kansas Department of Transportation
Contract 508021011
Federal Project No. IMD-035-3(399)
Water Well Plugging Record

Dear Sirs,

Please find enclosed three (3) copies of the Water Well Plugging Record (Form WWC-5P) completed for a well located on the above referenced KDOT project that is currently underway in Johnson County. This project is located at the interchange of I-35 and Lone Elm Road in Olathe Kansas. A copy of the record has been provided to KDOT (Olathe Construction Office) who owns the right-of-way for this project and an additional copy has been retained by our company.

If you have any questions, please contact me.

Sincerely,

APAC-Kansas, Inc.
Kansas City Division

A handwritten signature in black ink, appearing to read 'David J. Taggart', written over a horizontal line.

David J. Taggart, P.E.
Project Manager

CC: File