

WATER WELL RECORD

Form WWC-5


Division of Water Resources App. No.

1 LOCATION OF WATER WELL: County: JOHNSON	Fraction SW ¼ SE ¼ NW ¼ SW ¼	Section Number 12	Township No. T 14 S	Range Number R 23 <input checked="" type="checkbox"/> E <input type="checkbox"/> W
---	---------------------------------	----------------------	------------------------	---

Street/Rural Address of Well Location; if unknown, distance & direction from nearest town or intersection: If at owner's address, check here .
19865 W. 156TH STREET, OLATHE, KANSAS 66062

Global Positioning System (GPS) information:
 Latitude: (in decimal degrees)
 Longitude: (in decimal degrees)
 Elevation:
 Datum: WGS 84, NAD 83, NAD 27
 Collection Method:
 GPS unit (Make/Model:)
 Digital Map/Photo, Topographic Map, Land Survey
 Est. Accuracy: <3 m, 3-5 m, 5-15 m, >15 m

2 WATER WELL OWNER: TRANSAM TRUCKNG. INC.
 RR#, Street Address, Box #: 15910 S. 169 HWY
 City, State, ZIP Code : OLATHE, KANSAS 66062

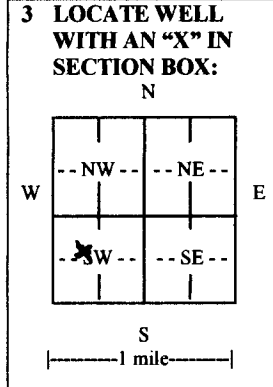

4 DEPTH OF COMPLETED WELL ^{Plugged} 500 ft. *1-500' Bore*

Depth(s) Groundwater Encountered (1) NONE ft. (2) ft. (3) ft.
 WELL'S STATIC WATER LEVEL *None* ft. below land surface measured on mo/day/yr.
 Pump test data: Well water was ft. after hours pumping gpm
 EST. YIELD. 0 gpm. Well water was ft. after hours pumping gpm
 Bore Hole Diameter 6 in. to 500 ft., and in. to ft.
 WELL WATER TO BE USED AS: Public water supply Geothermal Injection well
 Domestic Feedlot Oil field water supply Dewatering Other (Specify below)
 Irrigation Industrial Domestic-lawn & garden Monitoring well *1. Test Bore*
 Was a chemical/bacteriological sample submitted to Department? Yes No *for Geothermal*
 If yes, mo/day/yr sample was submitted.
 Water well disinfected? Yes No

5 TYPE OF CASING USED: Steel PVC Other *H.D. POLYETHYLENE*

CASING JOINTS: Glued Clamped Welded Threaded *Fusion*

Casing diameter *1.25* in. to *500* ft., Diameter in. to ft., Diameter in. to ft.
 Casing height above land surface *36* in., Weight *SDR11* lbs./ft., Wall thickness or gauge No. *160 PSI*

TYPE OF SCREEN OR PERFORATION MATERIAL: *None*

Steel Stainless Steel PVC Other (Specify)

Brass Galvanized Steel None used (open hole)

SCREEN OR PERFORATION OPENINGS ARE: *None*

Continuous slot Mill slot Gauze wrapped Torch cut Drilled holes None (open hole)
 Louvered shutter Key punched Wire wrapped Saw cut Other (specify)

SCREEN-PERFORATED INTERVALS: From ft. to ft., From ft. to ft.
 From ft. to ft., From ft. to ft.
 GRAVEL PACK INTERVALS: From ft. to ft., From ft. to ft.
 From ft. to ft., From ft. to ft.

6 GROUT MATERIAL: Neat cement Cement grout Bentonite Other

Grout Intervals: From *500* ft. to *0* ft., From ft. to ft., From ft. to ft.

What is the nearest source of possible contamination:

Septic tank Lateral lines Pit privy Livestock pens Insecticide storage Other (specify below)
 Sewer lines Cesspool Sewage lagoon Fuel storage Abandoned water well
 Watertight sewer lines Seepage pit Feedyard Fertilizer storage Oil well/gas well

Direction from well Distance from well

FROM	TO	LITHOLOGIC LOG	FROM	TO	LITHO. LOG (cont.) or PLUGGING INTERVALS
0	7	SOIL/CLAY 100-107 SHALE	266	282	SHALE
7	10	LIME 107-113 LIME	282	304	LIME
10	15	SANDSTONE 113-124 SHALE	304	312	SHALE
15	29	LIME 124-134 LIME	312	337	LIME
29	36	SHALE 134-174 SHALE	337	341	SHALE
36	52	LIME 174-194 LIME	341	350	LIME
52	59	SHALE 194-211 SHALE	350	500	SHALE
59	67	LIME 211-230 LIME			
67	76	SHALE 230-262 SHALE			
76	100	LIME 262-266 LIME			

7 CONTRACTOR'S OR LANDOWNER'S CERTIFICATION: This water well was constructed, reconstructed, or plugged under my jurisdiction and was completed on (mo/day/year) *9/24/2014* and this record is true to the best of my knowledge and belief.
 Kansas Water Well Contractor's License No. *561* This Water Well Record was completed on (mo/day/year) *7/8/2014*
 under the business name of *EVANS ENERGY DEVELOPMENT, INC.* by (signature) *[Signature]*

INSTRUCTIONS: Use typewriter or ball point pen. *PLEASE PRESS FIRMLY* and *PRINT* clearly. Please fill in blanks and check the correct answers. Send one copy to Kansas Department of Health and Environment, Bureau of Water, Geology Section, 1000 SW Jackson St., Suite 420, Topeka, Kansas 66612-1367. Telephone 785-296-5524. Send one copy to WATER WELL OWNER and retain one for your records. Include fee of \$5.00 for each constructed well. Visit us at <http://www.kdheks.gov/waterwell/index.html>