

WATER WELL PLUGGING RECORD Form WWC-5P

KSA 82a-1212

ID NO.

MW BG-01

1 LOCATION OF WATER WELL: County: Johnson	Fraction NE ¼ SE ¼ SE ¼ NW ¼	Section Number 17	Township Number T 14 S	Range Number R23 ☒ E ☐ W
---	---------------------------------	----------------------	---------------------------	--

Street/Rural Address of Well Location; if unknown, distance & direction from nearest town or intersection: If at owner's address, check here ☐ 2 miles NE of Gardner, KS. Accessed from KC by heading S on I-35 approx. 25 miles to exit 210 for US 56/W 175th


Global Positioning Systems (GPS) information:

Latitude: 38.834012109 (in decimal degrees)
Longitude: 94.880944192 (in decimal degrees)
Elevation:
Horizontal Datum: ☐ WGS84, ☒ NAD83, ☐ NAD27
Collection Method:

2 WATER WELL OWNER: US Army Corps of Engineers
RR#, St. Address, Box #: 601 E 12th Street
City, State ZIP Code: Kansas City, MO 64106

☒ GPS unit (Make/Model: Trimble 6000 GeoXT
☐ Digital Map/Photo, ☐ Topographic Map, ☐ Land Survey
Est. Accuracy: ☒ < 3 m, ☐ 3-5 m, ☐ 5-15 m, ☐ > 15 m

3 MARK WELL'S LOCATION WITH AN "X" IN SECTION BOX:

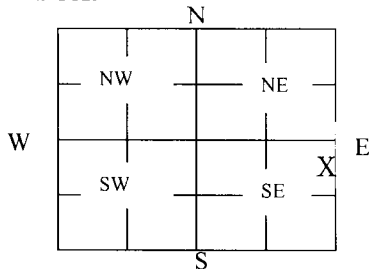

4 DEPTH OF WELL 18.3 ft.

WELL'S STATIC WATER LEVEL 10.6 ft

WELL WAS USED AS:

- | | | |
|-------------------------------------|---|--|
| ☐ Domestic | ☐ Public Water Supply | ☐ Dewatering |
| ☐ Irrigation | ☐ Oil Field Water Supply | ☒ Monitoring |
| ☐ Feedlot | ☐ Domestic (Lawn & Garden) | ☐ Injection Well |
| ☐ Industrial | ☐ Air Conditioning | ☐ Other |

Was a chemical/bacteriological sample submitted to Department? Yes ☐ No ☐

5 TYPE OF BLANK CASING USED:

- ☐ Steel ☐ RMP (SR) ☐ Wrought ☐ Fiberglass ☐ Other (Specify below)
☒ PVC ☐ ABS ☐ Asbestos-Cement ☐ Concrete Tile

Blank casing diameter 2 in. Was casing pulled? Yes ☒ No ☐ If yes, how much 4 ft.
Casing height above or below land surface +13.2 in.

6 GROUT PLUG MATERIAL: ☐ Neat cement ☒ Cement grout ☐ Bentonite ☐ Other

Grout Plug Intervals: From _____ ft. to _____ ft., From _____ ft. to _____ ft., From _____ ft. to _____ ft.

What is the nearest source of possible contamination:

- | | | | |
|---|---|---|--|
| ☐ Septic tank | ☐ Seepage pit | ☐ Fuel storage | ☐ Other (specify below) |
| ☐ Sewer lines | ☐ Pit privy | ☐ Fertilizer storage | |
| ☐ Watertight sewer lines | ☐ Sewage lagoon | ☐ Insecticide storage | |
| ☐ Lateral lines | ☐ Feedyard | ☐ Abandoned water well | Direction from well? _____ |
| ☐ Cess pool | ☐ Livestock pens | ☐ Oil well/Gas well | How many feet? _____ |

FROM	TO	PLUGGING MATERIALS	FROM	TO	PLUGGING MATERIALS
17.2 ft.	3 ft.	cement grout			
3 ft.	0 ft.	soil			

7 CONTRACTOR'S OR LANDOWNER'S CERTIFICATION: This water well was plugged under my jurisdiction and was completed on (mo/day/year) 09/10/2018 and this record is true to the best of my knowledge and belief. Kansas Water Well Contractor's License No. _____. This Water Well Record was completed on (mo/day/year) 3/6/2019 under the business name of USACE by (signature) _____

Send one white copy to Kansas Department of Health & Environment, Geology Section, 1000 SW Jackson Street, Ste. 420, Topeka, KS 66612-1367. Send one copy to WATER WELL OWNER and retain one for your records.
Visit us at <http://www.kdheks.gov/waterwell/index.html> Telephone 785-296-5524.

KSA82a-1212

Revised 1/20/2015