WATER WELL RECORD Form WWC-5 KSA 82a-1212

1 LOCATION OF WATER WELL: County: Johnson | Fraction: NE ¼ NE ¼ NE ¼ | Section Number: 25 | Township Number: T 14 S | Range Number: R 24 E/W

Distance and direction from nearest town or city street address of well if located within city?
1 Mile West & 3 North of St. Ilwell, Ks.

2 WATER WELL OWNER: Tom Lundberg
RR#, St. Address, Box #: 2345 Grand Blvd.
City, State, ZIP Code: Kansas City, Mo. 64108

8-160' Bores
Board of Agriculture, Division of Water Resources
Application Number:

3 LOCATE WELL'S LOCATION WITH AN "X" IN SECTION BOX:

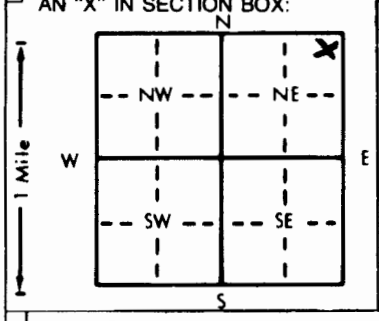

4 DEPTH OF COMPLETED WELL 160 ft. ELEVATION:
Depth(s) Groundwater Encountered 1. None ft. 2. ft. 3. ft.
WELL'S STATIC WATER LEVEL None ft. below land surface measured on mo/day/yr 3-9-00
Pump test data: Well water was ft. after hours pumping gpm
Est. Yield 0 gpm: Well water was ft. after hours pumping gpm
Bore Hole Diameter 5 1/8 in. to ft., and in. to ft.
WELL WATER TO BE USED AS: 1 Domestic 2 Irrigation 3 Feedlot 4 Industrial 5 Public water supply 6 Oil field water supply 7 Lawn and garden only 8 Air conditioning 9 Dewatering 10 Monitoring well 11 Injection well (12) Other (Specify below) Closed Loop Heat Pump
Was a chemical/bacteriological sample submitted to Department? Yes ..... No X ; If yes, mo/day/yr sample was submitted
Water Well Disinfected? Yes No X

5 TYPE OF BLANK CASING USED: 1 Steel 2 PVC 3 RMP (SR) 4 ABS 5 Wrought iron 6 Asbestos-Cement (7) Other (specify below) HD. Polyethylene 8 Concrete tile
CASING JOINTS: Glued Clamped Welded Fusion Threaded
Blank casing diameter 3/4 in. to 160 ft., Dia in. to ft., Dia in. to ft.
Casing height above land surface below 40 in., weight SDR 11 160 PSI lbs./ft. Wall thickness or gauge No.
TYPE OF SCREEN OR PERFORATION MATERIAL: None
1 Steel 2 Brass 3 Stainless steel 4 Galvanized steel 5 Fiberglass 6 Concrete tile 7 PVC 8 RMP (SR) 9 ABS 10 Asbestos-cement 11 Other (specify) 12 None used (open hole)
SCREEN OR PERFORATION OPENINGS ARE: 1 Continuous slot 2 Louvered shutter 3 Mill slot 4 Key punched 5 Gauzed wrapped 6 Wire wrapped 7 Torch cut 8 Saw cut 9 Drilled holes 10 Other (specify) 11 None (open hole)
SCREEN-PERFORATED INTERVALS: From ft. to ft., From ft. to ft.
From ft. to ft., From ft. to ft.
GRAVEL PACK INTERVALS: From ft. to ft., From ft. to ft.
From ft. to ft., From ft. to ft.

6 GROUT MATERIAL: 1 Neat cement 2 Cement grout (3) Bentonite 4 Other
Grout Intervals: From 160 ft. to 0 ft., From ft. to ft., From ft. to ft.
What is the nearest source of possible contamination:
1 Septic tank 2 Sewer lines 3 Watertight sewer lines 4 Lateral lines 5 Cess pool 6 Seepage pit 7 Pit privy 8 Sewage lagoon 9 Feedyard 10 Livestock pens 11 Fuel storage 12 Fertilizer storage 13 Insecticide storage 14 Abandoned water well 15 Oil well/Gas well 16 Other (specify below)
Direction from well? How many feet?

FROM	TO	LITHOLOGIC LOG
0	4	Soil + Clay
4	18	Limestone
18	20	Shale
20	58	Limestone
58	72	Shale
72	80	Limestone
80	112	Shale
112	118	Limestone
118	160	Shale

FROM	TO	PLUGGING INTERVALS
160	0	High Solids Bentonite

7 CONTRACTOR'S OR LANDOWNER'S CERTIFICATION: This water well was (1) constructed, (2) reconstructed, or (3) plugged under my jurisdiction and was completed on (mo/day/year) 3-9-00 and this record is true to the best of my knowledge and belief. Kansas Water Well Contractor's License No. 561 This Water Well Record was completed on (mo/day/yr) 3-14-00 under the business name of Evans Energy Dev. Inc. by (signature) Scott Evans (KGS)

INSTRUCTIONS: Use typewriter or ball point pen. *PLEASE PRESS FIRMLY* and *PRINT* clearly. Please fill in blanks, underline or circle the correct answers. Send top three copies to Kansas Department of Health and Environment, Bureau of Water, Topeka, Kansas 66620-0001. Telephone: 913-296-5545. Send one to WATER WELL OWNER and retain one for your records.

OFFICE USE ONLY T R E/W SEC. ¼ ¼ ¼