

WATER WELL RECORD

Form WWC-5

Division of Water Resources App. No.


1 LOCATION OF WATER WELL: County: JOHNSON	Fraction <i>NW 1/4 NE 1/4 SE 1/4 NE 1/4</i>	Section Number <i>25</i>	Township No. T <i>14</i> S	Range Number R <i>24</i> <input checked="" type="checkbox"/> E <input type="checkbox"/> W
---	--	-----------------------------	-------------------------------	--

Street/Rural Address of Well Location; if unknown, distance & direction from nearest town or intersection: If at owner's address, check here .

17720 Antioch Rd Bucyrus KS.

Global Positioning System (GPS) information:
 Latitude: (in decimal degrees)
 Longitude: (in decimal degrees)
 Elevation:
 Datum: WGS 84, NAD 83, NAD 27
 Collection Method:
 GPS unit (Make/Model:)
 Digital Map/Photo, Topographic Map, Land Survey
 Est. Accuracy: <3 m, 3-5 m, 5-15 m, >15 m

2 WATER WELL OWNER:
 RR#, Street Address, Box #: *Dan + Parthy Evans 13010 Carter*
 City, State, ZIP Code: *Overland Park, KS 66213*

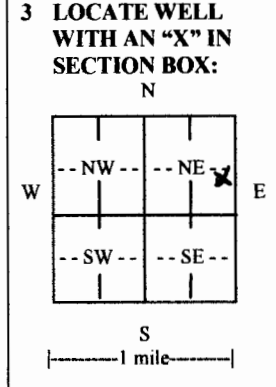

4 DEPTH OF COMPLETED WELL ft. *Plugged 200 5-200' Bores*

Depth(s) Groundwater Encountered (1). *NONE* ft. (2)..... ft. (3)..... ft.

WELL'S STATIC WATER LEVEL..... ft. below land surface measured on mo/day/yr.....

Pump test data: Well water was..... ft. after..... hours pumping..... gpm

EST. YIELD. *0*..... gpm. Well water was..... ft. after..... hours pumping..... gpm

Bore Hole Diameter *6*..... in. to *200*..... ft., and in. to ft.

WELL WATER TO BE USED AS: Public water supply Geothermal Injection well
 Domestic Feedlot Oil field water supply Dewatering Other (Specify below)
 Irrigation Industrial Domestic-lawn & garden Monitoring well CLOSED LOOP

Was a chemical/bacteriological sample submitted to Department? Yes No

If yes, mo/day/yr sample was submitted.....

Water well disinfected? Yes No

5 TYPE OF CASING USED: Steel PVC Other *H.D. POLYETHYLENE*.....

CASING JOINTS: Glued Clamped Welded Threaded *Fusion*

Casing diameter *3/4*..... in. to *200*..... ft., Diameter in. to ft., Diameter in. to ft.

Casing height above land surface *36*..... in., Weight *SDR11*..... lbs./ft., Wall thickness or gauge No. *160 PSI*.....

TYPE OF SCREEN OR PERFORATION MATERIAL: *None*

Steel Stainless Steel PVC Other (Specify)

Brass Galvanized Steel None used (open hole)

SCREEN OR PERFORATION OPENINGS ARE: *None*

Continuous slot Mill slot Gauze wrapped Torch cut Drilled holes None (open hole)
 Louvered shutter Key punched Wire wrapped Saw cut Other (specify)

SCREEN-PERFORATED INTERVALS: From..... ft. to ft., From..... ft. to ft.

GRAVEL PACK INTERVALS: From..... ft. to ft., From..... ft. to ft.

6 GROUT MATERIAL: Neat cement Cement grout Bentonite Other.....

Grout Intervals: From *200*..... ft. to *3*..... ft., From..... ft. to ft., From..... ft. to ft.

What is the nearest source of possible contamination:

Septic tank Lateral lines Pit privy Livestock pens Insecticide storage Other (specify below)
 Sewer lines Cesspool Sewage lagoon Fuel storage Abandoned water well
 Watertight sewer lines Seepage pit Feedyard Fertilizer storage Oil well/gas well

Direction from well Distance from well

FROM	TO	LITHOLOGIC LOG	FROM	TO	LITHO. LOG (cont.) or PLUGGING INTERVALS
0	5	SOIL/CLAY			
		151-172 LIME			
5	25	LIME			
		172-183 SHALE			
25	30	SHALE			
		182-200 LIME			
30	33	LIME			
33	40	SANDSTONE	200	3	5-200' BORES PLUGGED WITH
40	57	SHALE			HIGH SOLID BENTONITE
57	60	LIME			
60	93	SHALE			
93	97	LIME			
97	151	SHALE			

7 CONTRACTOR'S OR LANDOWNER'S CERTIFICATION: This water well was constructed, reconstructed, or plugged under my jurisdiction and was completed on (mo/day/year) *09/15/2014*.... and this record is true to the best of my knowledge and belief. Kansas Water Well Contractor's License No. *561*..... This Water Well Record was completed on (mo/day/year) *09/15/2014*..... under the business name of *EVANS ENERGY DEVELOPMENT, INC*..... by (signature) *[Signature]*.....

INSTRUCTIONS: Use typewriter or ball point pen. *PLEASE PRESS FIRMLY* and *PRINT* clearly. Please fill in blanks and check the correct answers. Send one copy to Kansas Department of Health and Environment, Bureau of Water, Geology Section, 1000 SW Jackson St., Suite 420, Topeka, Kansas 66612-1367. Telephone 785-296-5524. Send one copy to WATER WELL OWNER and retain one for your records. Include fee of \$5.00 for each constructed well. Visit us at <http://www.kdheks.gov/waterwell/index.html>