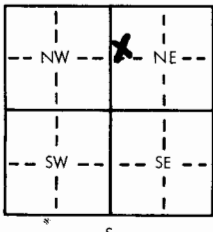
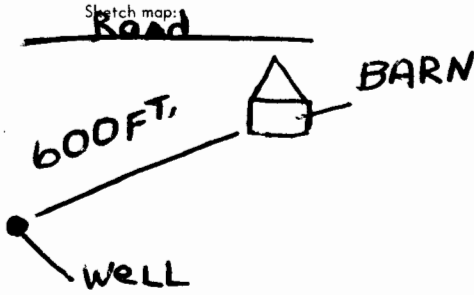


USE TYPEWRITER OR BALL POINT PEN-PRESS FIRMLY, PRINT CLEARLY.

WATER WELL RECORD  
KSA 82a-1201-1215

Kansas Department of Health and Environment-Division of Environment  
(Water well Contractors)  
Topeka, Kansas 66620

1. Location of well: County <b>JOHNSON</b> Fraction <b>SW 1/4 NW 1/4 NE 1/4</b> Section number <b>28</b> Township number <b>T 14 S</b> Range number <b>R 25 E 0</b>	
2. Distance and direction from nearest town or city: <b>Then 1 mile (N) &amp; 3/4 mile (E)</b> Street address of well location if in city: <b>N/A</b>	
3. Owner of well: <b>Ben Brown</b> R.R. or street: <b>630 Westover Rd.</b> City, state, zip code: <b>Kan. City, Mo 64113</b>	
4. Locate with "X" in section below: <div style="display: flex; justify-content: space-around; align-items: center;"> <div style="text-align: center;"> <p>1 Mile</p>  <p>1 Mile</p> </div> <div style="text-align: center;"> <p>Sketch map:</p>  </div> </div>	
5. Type and color of material	
	From To
<b>SURFACE</b>	<b>0 3</b>
<b>CLAY (BRN)</b>	<b>3 7</b>
<b>BROKEN ROCK</b>	<b>7 13</b>
<b>Limestone (GREY)</b>	<b>13 23</b>
<b>SANDSTONE (GREY)</b>	<b>23 29</b>
<b>Shale (Lt)</b>	<b>29 59</b>
<b>Limestone (GREY)</b>	<b>59 60</b>
<b>TOTAL DEPTH</b>	<b>60'</b>
(Use a second sheet if needed)	
18. Elevation: <b>930</b> Topography: <input checked="" type="checkbox"/> Hill <input checked="" type="checkbox"/> Slope <input type="checkbox"/> Upland <input type="checkbox"/> Valley	19. Remarks: <b>Customer is aware of state regulations and agrees to install a 4' square reinforced platform of concrete around top of well.</b> <b>Benjamin H. Brown</b>
6. Bore hole dia. <b>8"</b> in. Completion date <b>2/5/80</b> Well depth <b>60</b> ft.	
7. <input checked="" type="checkbox"/> Cable tool <input type="checkbox"/> Rotary <input type="checkbox"/> Driven <input type="checkbox"/> Dug <input type="checkbox"/> Hollow rod <input type="checkbox"/> Jetted <input type="checkbox"/> Bored <input type="checkbox"/> Reverse rotary	
8. Use: <input checked="" type="checkbox"/> Domestic <input type="checkbox"/> Public supply <input type="checkbox"/> Industry <input type="checkbox"/> Irrigation <input type="checkbox"/> Air conditioning <input type="checkbox"/> Stock <input type="checkbox"/> Lawn <input type="checkbox"/> Oil field water <input type="checkbox"/> Other	
9. Casing: Material _____ Height: <u>Above</u> or below Threaded _____ Welded _____ Surface <b>12</b> in. RMP <input checked="" type="checkbox"/> PVC <input checked="" type="checkbox"/> Weight _____ lbs./ft. Dia. <b>5</b> in. to <b>60</b> ft. depth Wall Thickness: _____ inches or Dia. _____ in. to _____ ft. depth gage No. <b>3/16</b>	
10. Screen: Manufacturer's name _____ Type _____ Dia. _____ Slot/gauze _____ Length _____ Set between _____ ft. and _____ ft. _____ ft. and _____ ft. Gravel pack? <input checked="" type="checkbox"/> YES Size range of material <b>1/4 X 3/8</b>	
11. Static water level: _____ mo./day/yr. <b>20</b> ft. below land surface Date <b>2/6/80</b>	
12. Pumping level below land surfaces: _____ ft. after _____ hrs. pumping _____ g.p.m. _____ ft. after _____ hrs. pumping _____ g.p.m. Estimated maximum yield <b>3</b> g.p.m.	
13. Water sample submitted: _____ mo./day/yr. Yes <input checked="" type="checkbox"/> No <input type="checkbox"/> Date _____	
14. Well head completion: <input checked="" type="checkbox"/> Pitless adapter _____ Inches above grade	
15. Well grouted? _____ With: <input checked="" type="checkbox"/> Neat cement <input type="checkbox"/> Bentonite <input type="checkbox"/> Concrete Depth: From <b>4</b> ft. to <b>15</b> ft.	
16. Nearest source of possible contamination: _____ ft. <b>600FT</b> Direction <b>NE</b> Type <b>BARN</b> Well disinfected upon completion? <input checked="" type="checkbox"/> Yes <input type="checkbox"/> No	
17. Pump: <input checked="" type="checkbox"/> Not installed Manufacturer's name _____ Model number _____ HP _____ Volts _____ Length of drop pipe _____ ft. capacity _____ g.p.m. Type: <input type="checkbox"/> Submersible <input type="checkbox"/> Turbine <input type="checkbox"/> Jet <input type="checkbox"/> Reciprocating <input type="checkbox"/> Centrifugal <input type="checkbox"/> Other	
20. Water well contractor's certification: This well was drilled under my jurisdiction and this report is true to the best of my knowledge and belief. <b>A.S. GLAZE Drill Co 350</b> Business name License No. _____ Address <b>15710 S. Woodland Rd - Olathe</b> Signe <b>Alvin H. Glaze</b> Date <b>2/7/80</b> Authorized representative	

Forward the white, blue and pink copies to the Department of Health and Environment

Form WWC-5

T 14 R 25 E  
 W 28 S  
 Sec 28 SW  
 1/4 NE