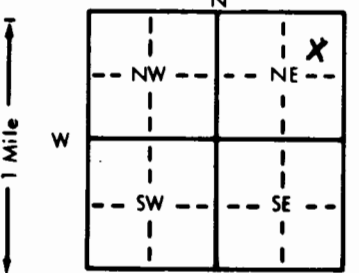


1 LOCATION OF WATER WELL: Fraction 1/4 Lot 3 of 1/4 Section Number 34 Township Number T 14 S Range Number R 25E E/W
 County: JOHNSON

Distance and direction from nearest town or city street address of well if located within city?
2 miles East & 1 Mile North of Stillwell - Subdivision of Heritage Trails II

2 WATER WELL OWNER: Mr. Phillip Ptacek
 RR#, St. Address, Box # : 18435 Aberdeen Board of Agriculture, Division of Water Resources
 City, State, ZIP Code : Stillwell, KS 66085 Application Number:

3 LOCATE WELL'S LOCATION WITH AN "X" IN SECTION BOX:

 4 DEPTH OF COMPLETED WELL 270 ft. ELEVATION:
 Depth(s) Groundwater Encountered 1. 250 ft. 2. _____ ft. 3. _____ ft.
 WELL'S STATIC WATER LEVEL 165 ft. below land surface measured on mo/day/yr 12/7/91
 Pump test data: Well water was 260 ft. after 1/2 hours pumping 14 gpm
 Est. Yield 1/2 gpm: Well water was _____ ft. after _____ hours pumping _____ gpm
 Bore Hole Diameter 8 in. to _____ ft., and _____ in. to _____ ft.
 WELL WATER TO BE USED AS:
 1 Domestic 3 Feedlot 6 Oil field water supply 9 Dewatering 12 Other (Specify below)
 2 Irrigation 4 Industrial 7 Lawn and garden only 10 Observation well
 Was a chemical/bacteriological sample submitted to Department? Yes _____ No X; If yes, mo/day/yr sample was submitted
 Water Well Disinfected? Yes X No

5 TYPE OF BLANK CASING USED:
 1 Steel 3 RMP (SR) 5 Wrought iron 8 Concrete tile CASING JOINTS: Glued X Clamped _____
 2 PVC 4 ABS 6 Asbestos-Cement 9 Other (specify below) Welded _____
 7 Fiberglass Threaded _____
 Blank casing diameter _____ in. to _____ ft., Dia _____ in. to _____ ft., Dia _____ in. to _____ ft.
 Casing height above land surface 18 in., weight _____ lbs./ft. Wall thickness or gauge No. _____
 TYPE OF SCREEN OR PERFORATION MATERIAL:
 7 PVC 10 Asbestos-cement
 1 Steel 3 Stainless steel 5 Fiberglass 8 RMP (SR) 11 Other (specify) _____
 2 Brass 4 Galvanized steel 6 Concrete tile 9 ABS 12 None used (open hole)
 SCREEN OR PERFORATION OPENINGS ARE:
 1 Continuous slot 3 Mill slot 5 Gauzed wrapped 8 Saw cut 11 None (open hole)
 2 Louvered shutter 4 Key punched 6 Wire wrapped 9 Drilled holes
 7 Torch cut 10 Other (specify) _____
 SCREEN-PERFORATED INTERVALS: From 30-60 ft. to 60-90 ft., From 90-120 ft. to 120-150 ft.
 From 150-180 ft. to 180-210 ft., From 210-240 ft. to 240-270 ft.
 GRAVEL PACK INTERVALS: From 30 ft. to 270 ft., From _____ ft. to _____ ft.

6 GROUT MATERIAL: 1 Neat cement 2 Cement grout 3 Bentonite 4 Other _____
 Grout intervals: From 3 ft. to 23 ft., From _____ ft. to _____ ft., From _____ ft. to _____ ft.
 What is the nearest source of possible contamination:
 1 Septic tank 4 Lateral lines 7 Pit privy 10 Livestock pens 14 Abandoned water well
 2 Sewer lines 5 Cess pool 8 Sewage lagoon 11 Fuel storage 15 Oil well/Gas well
 3 Watertight sewer lines 6 Seepage pit 9 Feedyard 12 Fertilizer storage 16 Other (specify below)
 13 Insecticide storage _____
 Direction from well? Northeast How many feet? 220 ft

FROM	TO	LITHOLOGIC LOG	FROM	TO	LITHOLOGIC LOG
0	4	Surface soil	222	241	Lime
4	64	Lime	241	246	Shale/Black Slate
64	80	Shale	246	248	Lime
80	92	Lime	248	253	Shale
92	120	Shale	253	261	Lime
120	125	Lime	261	270	Shale TD
125	150	Shale			
150	160	Lime			
160	180	Shale			
180	185	Lime			
185	188	Shale			
188	214	Lime			
214	218	Shale			
218	220	Lime			
220	222	Shale			

7 CONTRACTOR'S OR LANDOWNER'S CERTIFICATION: This water well was (1) constructed, (2) reconstructed, or (3) plugged under my jurisdiction and was completed on (mo/day/year) 12/7/91 and this record is true to the best of my knowledge and belief. Kansas
 Water Well Contractor's License No. 338 This Water Well Record was completed on (mo/day/yr) 12/12/91
 under the business name of Jayhawk Drilling by (signature) Thomas F. Mayhew

INSTRUCTIONS: Use typewriter or ball point pen. PLEASE PRESS FIRMLY and PRINT clearly. Please fill in blanks, underline or circle the correct answers. Send top three copies to Kansas Department of Health and Environment, Office of Oil Field and Environmental Geology, Regulation and Permitting Section, Topeka, Kansas 66620-7500, Telephone: 913-862-9360. Send one to WATER WELL OWNER and retain one for your records.