WATER WELL RECORD Form WWC-5 KSA 82a-1212

1 LOCATION OF WATER WELL: County: JOHNSON	Fraction: SW ¼ SE ¼ NW ¼	Section Number: 35	Township Number: T 14 S	Range Number: R 25 (E) W

Distance and direction from nearest town or city street address of well if located within city? 1/2 MILE S. OF INTERSECTION OF STATE LINE ROAD & 183RD STREET

2 WATER WELL OWNER: WILLIAM R GRUBB
RR#, St. Address, Box # : 2418 SUMMIT
City, State, ZIP Code : KC MO 64145

Board of Agriculture, Division of Water Resources Application Number:

3 LOCATE WELL'S LOCATION WITH AN "X" IN SECTION BOX:

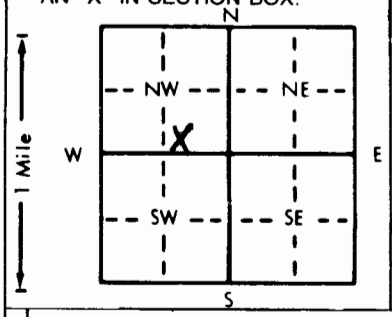

4 DEPTH OF COMPLETED WELL 220 ft. ELEVATION:
Depth(s) Groundwater Encountered 1. 163 ft. 2. ft. 3. ft.
WELL'S STATIC WATER LEVEL 100' ft. below land surface measured on mo/day/yr
Pump test data: Well water was ft. after hours pumping gpm
Est. Yield 40 GPH Well water was ft. after hours pumping gpm
Bore Hole Diameter 8 1/2 in. to 220 ft., and in. to ft.
WELL WATER TO BE USED AS: 1 Domestic 2 Irrigation 3 Feedlot 4 Industrial 5 Public water supply 6 Oil field water supply 7 Lawn and garden only 8 Air conditioning 9 Dewatering 10 Monitoring well 11 Injection well 12 Other (Specify below)
Was a chemical/bacteriological sample submitted to Department? Yes No X; If yes, mo/day/yr sample was submitted
Water Well Disinfected? Yes No

5 TYPE OF BLANK CASING USED: 1 Steel 2 PVC 3 RMP (SR) 4 ABS 5 Wrought iron 6 Asbestos-Cement 7 Fiberglass 8 Concrete tile 9 Other (specify below)
CASING JOINTS: Glued X Clamped Welded Threaded
Blank casing diameter 5" in. to 40 ft., Dia 5 in. to ft., Dia in. to ft.
Casing height above land surface 18 in., weight lbs./ft. Wall thickness or gauge No. SDR 26
TYPE OF SCREEN OR PERFORATION MATERIAL: 1 Steel 2 Brass 3 Stainless steel 4 Galvanized steel 5 Fiberglass 6 Concrete tile 7 PVC 8 RMP (SR) 9 ABS 10 Asbestos-cement 11 Other (specify) 12 None used (open hole)
SCREEN OR PERFORATION OPENINGS ARE: 1 Continuous slot 2 Louvered shutter 3 Mill slot 4 Key punched 5 Gauzed wrapped 6 Wire wrapped 7 Torch cut 8 Saw cut 9 Drilled holes 10 Other (specify) 11 None (open hole)
SCREEN-PERFORATED INTERVALS: From 40 ft. to 60 ft., From 100 ft. to 120 ft.
From 160 ft. to 180 ft., From 200 ft. to 220 ft.
GRAVEL PACK INTERVALS: From 220 ft. to 25 ft., From ft. to ft.
From ft. to ft., From ft. to ft.

6 GROUT MATERIAL: 1 Neat cement 2 Cement grout 3 Bentonite 4 Other
Grout Intervals: From 25 ft. to 4 ft., From ft. to ft., From ft. to ft.
What is the nearest source of possible contamination: 1 Septic tank 2 Sewer lines 3 Watertight sewer lines 4 Lateral lines 5 Cess pool 6 Seepage pit 7 Pit privy 8 Sewage lagoon 9 Feedyard 10 Livestock pens 11 Fuel storage 12 Fertilizer storage 13 Insecticide storage 14 Abandoned water well 15 Oil well/Gas well 16 Other (specify below)
Direction from well? How many feet? 300'

FROM	TO	LITHOLOGIC LOG	FROM	TO	PLUGGING INTERVALS
0	1/2	SURFACE	124	163	SHALE (SANDY BOTTOM)
1/2	12	LIME	163	173	LIME
12	13	CLAY	173	175	SHALE
13	22	LIME	175	176	LIME
22	24	SHALE	176	186	SHALE
24	25	LIME	186	200	LIME
25	28	SHALE	200	203	SHALE
28	61	LIME	203	213	LIME
61	76	SHALE	213	220	SHALE
76	86	LIME			
86	108	SHALE			
108	112	SHALE (RED)			
112	113	LIME			
113	120	SHALE			
120	124	LIME			

(BLANK CASING 0-40', 60'-100', 120'-160', 160'-200')

7 CONTRACTOR'S OR LANDOWNER'S CERTIFICATION: This water well was (1) constructed, (2) reconstructed, or (3) plugged under my jurisdiction and was completed on (mo/day/year) 5/10/91 and this record is true to the best of my knowledge and belief. Kansas Water Well Contractor's License No. 240 This Water Well Record was completed on (mo/day/yr) 6/19/91 under the business name of FEYOUNG DRILLING CO by (signature) Rod Young

INSTRUCTIONS: Use typewriter or ball point pen. *PLEASE PRESS FIRMLY* and *PRINT* clearly. Please fill in blanks, underline or circle the correct answers. Send top three copies to Kansas Department of Health and Environment, Bureau of Water, Topeka, Kansas 66620-7320. Telephone: 913-296-5545. Send one to WATER WELL OWNER and retain one for your records.

OFFICE USE ONLY T R E/W SEC. ¼ ¼ ¼