

**WATER WELL RECORD**

**Form WWC-5**


Division of Water Resources App. No.  

<b>1 LOCATION OF WATER WELL:</b> County: JOHNSON	Fraction <i>NW 1/4 SE 1/4 NW 1/4 SW 1/4</i>	Section Number <i>27</i>	Township No. <i>T 14 S</i>	Range Number <i>R 25</i> <input checked="" type="checkbox"/> E <input type="checkbox"/> W
---	--	-----------------------------	-------------------------------	--

Street/Rural Address of Well Location; if unknown, distance & direction from nearest town or intersection: If at owner's address, check here   
**3691 W. 180TH TERRACE, STILLWELL, KS 66085**

**Global Positioning System (GPS) information:**  
 Latitude: *38 20 11.25* (in decimal degrees)  
 Longitude: *-94 62 41.6* (in decimal degrees)  
 Elevation: .....  
 Datum:  WGS 84,  NAD 83,  NAD 27  
 Collection Method:  
 GPS unit (Make/Model: .....)  
 Digital Map/Photo,  Topographic Map,  Land Survey  
 Est. Accuracy:  <3 m,  3-5 m,  5-15 m,  >15 m

**2 WATER WELL OWNER:** *Shawn + Rebecca Polowniak*  
 RR#, Street Address, Box #: *14690 Travis Apt 27202*  
 City, State, ZIP Code : *Overland Park, KS 66223*

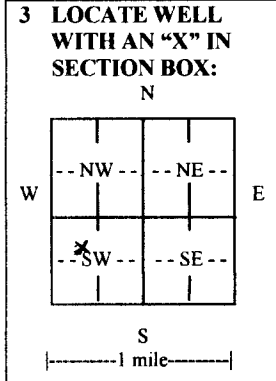

**4 DEPTH OF COMPLETED WELL** *Plugged* ..... *400* ft. *5-400' BORES*

Depth(s) Groundwater Encountered (1) *0* ft. (2) ..... ft. (3) ..... ft.  
 WELL'S STATIC WATER LEVEL ..... ft. below land surface measured on mo/day/yr.....  
 Pump test data: Well water was ..... ft. after ..... hours pumping ..... gpm  
 EST. YIELD *0* gpm. Well water was ..... ft. after ..... hours pumping ..... gpm  
 Bore Hole Diameter *5 5/8* in. to *400* ft., and ..... in. to ..... ft.  
 WELL WATER TO BE USED AS:  Public water supply  Geothermal  Injection well  
 Domestic  Feedlot  Oil field water supply  Dewatering  Other (Specify below)  
 Irrigation  Industrial  Domestic-lawn & garden  Monitoring well **CLOSED LOOP**  
 Was a chemical/bacteriological sample submitted to Department?  Yes  No  
 If yes, mo/day/yr sample was submitted.....  
 Water well disinfected?  Yes  No

**5 TYPE OF CASING USED:**  Steel  PVC  Other *H.D. POLYETHYLENE*.....  
 CASING JOINTS:  Glued  Clamped  Welded  Threaded *Fusion*  
 Casing diameter *1* in. to *400* ft., Diameter ..... in. to ..... ft., Diameter ..... in. to ..... ft.  
 Casing height above *dry* surface *36* in., Weight *SDR11* lbs./ft., Wall thickness or gauge No. *160 PSI*  
 TYPE OF SCREEN OR PERFORATION MATERIAL: *None*  
 Steel  Stainless Steel  PVC  Other (Specify) .....  
 Brass  Galvanized Steel  None used (open hole)  
 SCREEN OR PERFORATION OPENINGS ARE: *None*  
 Continuous slot  Mill slot  Gauze wrapped  Torch cut  Drilled holes  None (open hole)  
 Louvered shutter  Key punched  Wire wrapped  Saw cut  Other (specify) .....  
 SCREEN-PERFORATED INTERVALS: From ..... ft. to ..... ft., From ..... ft. to ..... ft.  
 GRAVEL PACK INTERVALS: From ..... ft. to ..... ft., From ..... ft. to ..... ft.

**6 GROUT MATERIAL:**  Neat cement  Cement grout  Bentonite  Other .....  
 Grout Intervals: From *400* ft. to *3* ft., From ..... ft. to ..... ft., From ..... ft. to ..... ft.  
 What is the nearest source of possible contamination:  
 Septic tank  Lateral lines  Pit privy  Livestock pens  Insecticide storage  Other (specify below)  
 Sewer lines  Cesspool  Sewage lagoon  Fuel storage  Abandoned water well  
 Watertight sewer lines  Seepage pit  Feedyard  Fertilizer storage  Oil well/gas well .....  
 Direction from well ..... Distance from well .....

FROM	TO	LITHOLOGIC LOG	FROM	TO	LITHO. LOG (cont.) or PLUGGING INTERVALS
0	1	SOIL/CLAY 156-183 LIME	260	275	SANDSTONE
1	16	SANDSTONE 183-192 SHALE	275	348	SHALE
16	27	LIME 192-212 LIME	348	360	SANDSTONE
27	48	SHALE 212-216 SHALE	360	400	SHALE
48	55	LIME 216-220 LIME			
55	89	SHALE 220-222 SHALE			
89	93	LIME 222-233 LIME	400	3	5-400' BORES PLUGGED WITH
93	120	SHALE 233-238 SHALE			HIGH SOLID BENTONITE
120	133	SANDSTONE 238-249 SANDSTONE			
133	156	SHALE 249-260 SHALE			

**7 CONTRACTOR'S OR LANDOWNER'S CERTIFICATION:** This water well was  constructed,  reconstructed, or  plugged under my jurisdiction and was completed on (mo/day/year) *03/24/2015*.... and this record is true to the best of my knowledge and belief. Kansas Water Well Contractor's License No. *561*..... This Water Well Record was completed on (mo/day/year) *03/25/2015*..... under the business name of *EVANS ENERGY DEVELOPMENT, INC.*.... by (signature) *[Signature]*.....

**INSTRUCTIONS:** Use typewriter or ball point pen. **PLEASE PRESS FIRMLY** and **PRINT** clearly. Please fill in blanks and check the correct answers. Send one copy to Kansas Department of Health and Environment, Bureau of Water, Geology Section, 1000 SW Jackson St., Suite 420, Topeka, Kansas 66612-1367. Telephone 785-296-5524. Send one copy to WATER WELL OWNER and retain one for your records. Include fee of \$5.00 for each constructed well. Visit us at <http://www.kdheks.gov/waterwell/index.html>